HELLAND ENGINEERING

Document Number: 2008011566

Date: Dec 04, 2007 4:30:00 pm

Aud Fee: 0.00 Rec Fee:

Trans Tax: 0.00 Rec Management Fee: E-Com Fee: 1.00

5.00

1.00

0.00

Non-Standard Page Fee: Filed for record in Black Hawk County, Iowa 7 Judith A. McCarthy, County Recorder

Jeffrey P. Helland, 1107 Technology Parkway, Cedar Falls, Iowa 50613-6951, (319)-266-0161

UNITED STATES PUBLIC LAND SURVEY CORNER CERTIFICATE OF

LAND SURVEY MONUMENTS SITUATED IN SECTION NO.__ <u>17</u>, TOWNSHIP NO.<u>87</u>NORTH, RANGE

P

_WEST OF THE FIFTH PRINCIPAL MERIDIAN, BLACK HAWK NO. 12 COUNTY, IOWA.

PREVIOUSLY RECORDED IN 297 MISC. 247

(SHOW REASON FOR PREPARING THIS CERTIFICATE, THE EVIDENCE AND DETAILED PROCEDURES USED IN ESTABLISHING THE CORNER POSITIONS AND MONUMENTATION FOUND OR PLACED.)

MONUMENT DESCRIPTION AND REMARKS:


USPLSCC 297 MISC. 247 MONUMENTATION AND REFERENCE TIES HAVE CHANGED. SURVEY COMPLETED IN THE SE 1/4 OF SEC. 9-T87N-R12W.

NE CORNER: NO BLACK HAWK COUNTY ENGINEER REFERENCE TIES AVAILABLE. WPA CHAINING NOTES DATED 8/22/41 CALL FOR [C.M.]. USPLSCC 297 MISC. 247 CALLS FOR [FOUND NO. 6 REBAR]. FOUND NO. 6 REBAR (1' LONG) THAT WAS LEANING NORTHERLY. TIED OUT, REMOVED & FOUND A STANDARD CONCRETE MONUMENT w/BRASS CAP (ILLEGIBLE) AT A DEPTH OF 1.7 FEET. TOP OF NO. 6 REBAR WAS WITHIN 0.1'Ø OF BEING ABOVE THE CENTER OF FOUND C..M. SET NO. 4 REBAR (1.4' LONG) W/ALUMINUM CAP #16264 DIRECTLY ON TOP OF SAID C.M. TOP OF SAID C. ON TOP OF SAID C.M. TOP OF SAID NO. 4 IS CURRENTLY 0.3' DEEP.

(SHOW A MINIMUM OF THREE REFERENCE TIES TO DURABLE PHYSICAL OBJECTS, RELEVANT MONUMENTS AND PHYSICAL CONDITIONS THAT WILL ENABLE RECOVERY OF THE CORNER.)

PLAN VIEW

(0.0')¢ PER WPA CHAINING NOTES DATED 8/22/41

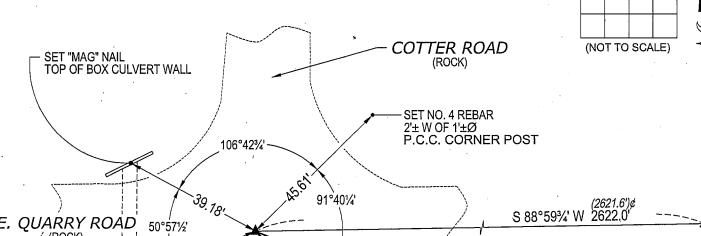

E. QUARRY ROAD (ROCK) 39.04°

SET "MAG" NAIL TOP OF BOX CULVERT WALL

NE CORNER

FOUND SHINER

N FACE CORNER POST

JEFFREY P. HELLAND

16264

AWO1

HELLAND ENGINEERING & SURVEYING, LTD.

110°391/2'

1107 Technology Parkway Cedar Falls, Iowa 50613-6951 (319)-266-0161

I hereby certify that this land surveying document was prepared and the related survey work was performed by me or under my direct personal supervision and that I am a duly licensed Land Surveyor under the laws of the State of lowa.

Jeffrey P. Helland License Number 16264

My license renewal date is December 31, 2007.
All pages or sheets are covered by this seal except:

(BEARINGS ARE ASSUMED)

SHINER = 8D NAIL & 1 5/16"Ø METAL SHINER

BRASS TAG = 13/16"Ø BRASS TAG OPC = PLASTIC CAP (O=ORANGE, R=RED, Y=YELLOW) (00") RECORDED AS FILE NAME: 07-268C1.DWG

LIST CORNERS TO BE INDEXED

TOWNSHIP CORNER SECTION RANGE 12W **NE CORNER** 17 87N

S 1/4 CORNER SEC. 9-T87N-R12W SET NO. 4 REBAR

w/ALUMINUM CAP #16264