

United States Public Land Survey Corner Certificate of

Land Survey Monuments situated in Section No. 10, Township No. 87 North,
 Range No. 13 West, of the Fifth Principal Meridian, Black Hawk County, Iowa
 Previously recorded in 330 Misc 055 & Doc. #2008005239.

Show reason for preparing this certificate, the evidence and detailed procedures used in establishing the corner positions and monumentation found or placed.)

Monument Description and Remarks: North 1/4 Corner -- Section 10 - T87N - R13W


330 Misc 055 calls out setting a 1/2"Øx24" rebar with yellow cap #8033 and Doc. #2008005239 calls out finding pin and yellow cap per 330 Misc 055
Searched area and found 1/2"Ø rebar with damaged yellow cap at location indicated by previous corner certificates.

Corner was used for a survey in the SE 1/4 of 3-T87N-13W.

This corner certificate is being prepared to update the reference ties.

PLAN - VIEW

(Show a minimum of three reference ties to durable physical objects, relevant monuments and physical conditions that will enable recovery of the corner.)

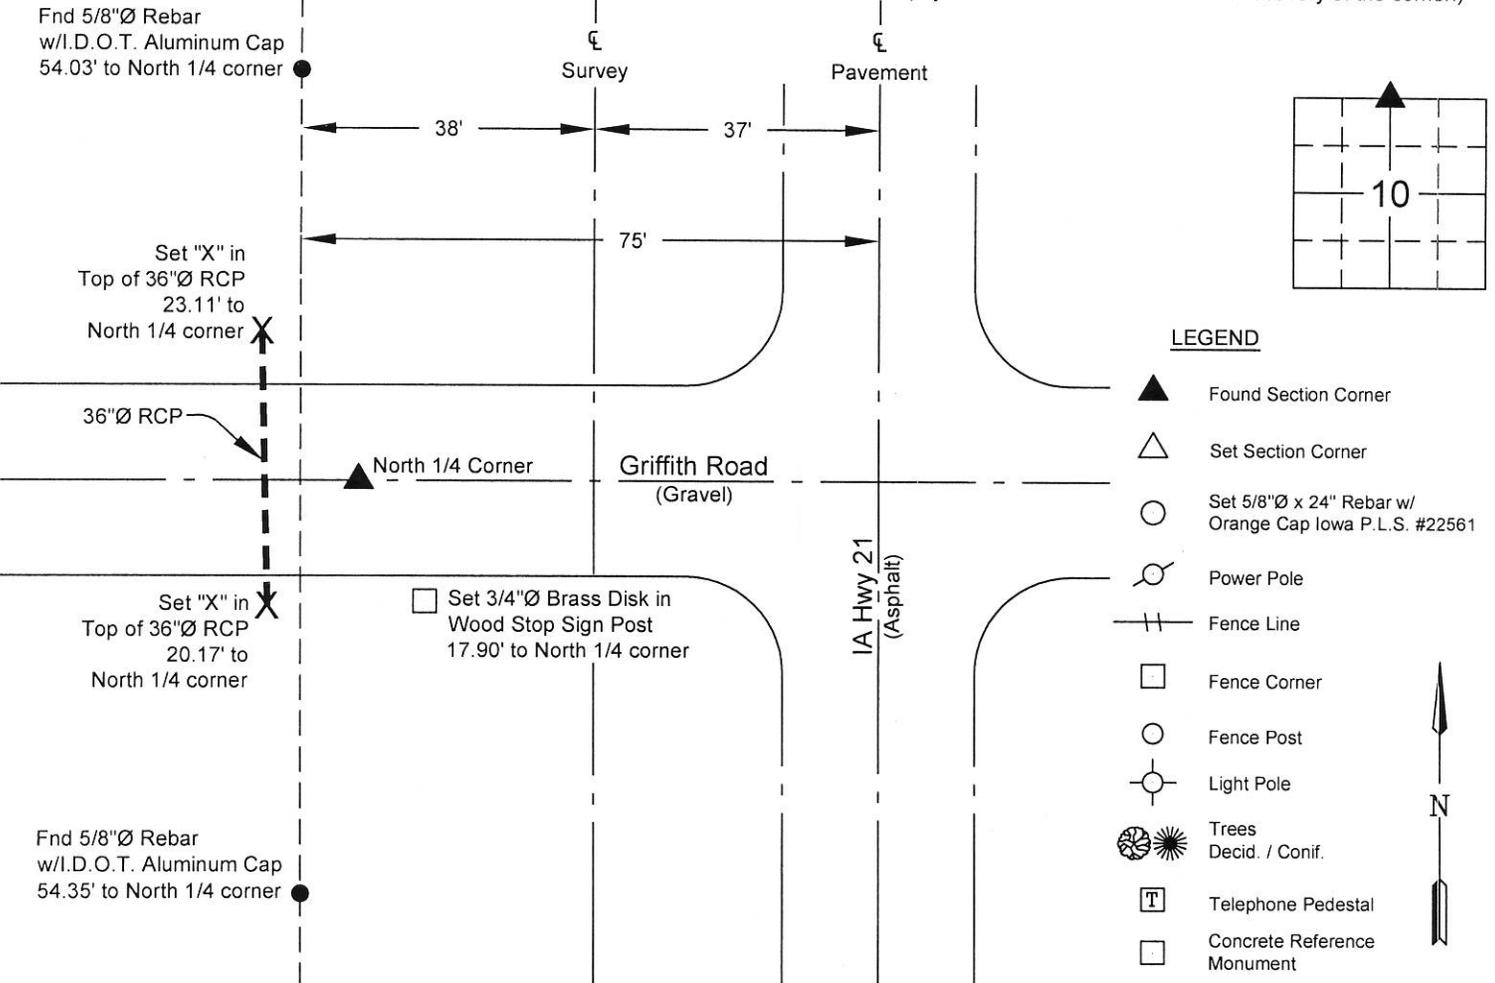

LEGEND

- Found Section Corner
- Set Section Corner
- Set 5/8"Ø x 24" Rebar w/ Orange Cap Iowa P.L.S. #22561
- Power Pole
- Fence Line
- Fence Corner
- Fence Post
- Light Pole
- Trees
Decid. / Conif.
- Telephone Pedestal
- Concrete Reference Monument



I hereby certify that this land surveying document was prepared and the related survey work was performed by me or under my direct personal supervision and that I am a duly licensed Land Surveyor under the laws of the State of Iowa.

Matthew A. Kofta 3/24/17
 Matthew A. Kofta, P.L.S. Date

License Number 22561
 My license renewal date is December 31, 2018
 Pages or sheets covered by this seal: 1

List Corner to be Indexed

Corner	Section	Twp	Range
North 1/4	10	87 North	13 West



VJ Engineering
 1501 Technology Parkway
 Cedar Falls, Iowa - 319-266-5829

Section Corner
 Reference Ties

file no.
178020
 drawn by
MAK
 date
3/24/17