

PREPARED BY: BLACK HAWK COUNTY ENGINEERS OFFICE  
316 E. FIFTH STREET, ROOM 211 WATERLOO, IOWA 50703PH.# (319) 833-3008  
FAX# (319) 833-3139SLSI 9-94  
CERT 12-96

UNITED STATES PUBLIC LAND SURVEY CORNER CERTIFICATE OF  
Land Survey Monuments situated in Section 21, Township 87 N,  
Range 13 W, of the Fifth Principal Meridian, BLACK HAWK County, Iowa.  
Previously recorded in Fee Book 2003, Page 35899, in County Recorder's Office.

(Show reason for preparing this certificate, the evidence and detailed procedures used in establishing the corner positions and monumentation found or placed.)

**Monument Description and Remarks:** FND. #5 RBR PRIOR TO RESURF. PROJECT.  
RECORD TIES DESTROYED, PER NEW POWER POLES & INTERSECTION PROJECT 2006.  
CORNER TEMP. REF. AND RETIED AS DENOTED, DUE TO PLAN 5½" HMA RESURFACING.  
GEOMETRIC SECTION LINE REFERENCE TO NORTH AND EAST PER RECORD MEASURED  
REFERENCE NORTH, AND R.O.W. ACQUISITION PLAT OF RECORD AT N.E. COR. INT.  
RESET #5 REBAR × 5½" L., LOC. 0.10' SOUTH OF C.L. ACC JOINT E/W, AND ALIGNED  
w/ C.L. KIMBALL AVE. (±) N/S.

## PLAN - VIEW


(Show a minimum of three reference ties to durable physical objects, relevant monuments and physical conditions that will enable recovery of the corner.)

## NOTES:


- 1.) TIES PER EDM MEASURE IN REFLECTORLESS MODE, UTIL. INDIRECT MEASURE (M.L.M.).
- 2.) SECTION LINE DISTANCE REFERS TO "LOCAL GROUND" MEAS. AND INCLUDES ELLIPSOIDAL (COMBINED) SCALE FACTOR FROM NAD83 S.P.C. GRID INVERSE (AS OBSERVED).
- 3.) "P" DENOTES PLATTED DIMENSION PER RECORD PLAT BY PLS #6505.

E. 1/4 COR.  
16-87-13  
PER MISC.  
295-278

NOT TO SCALE

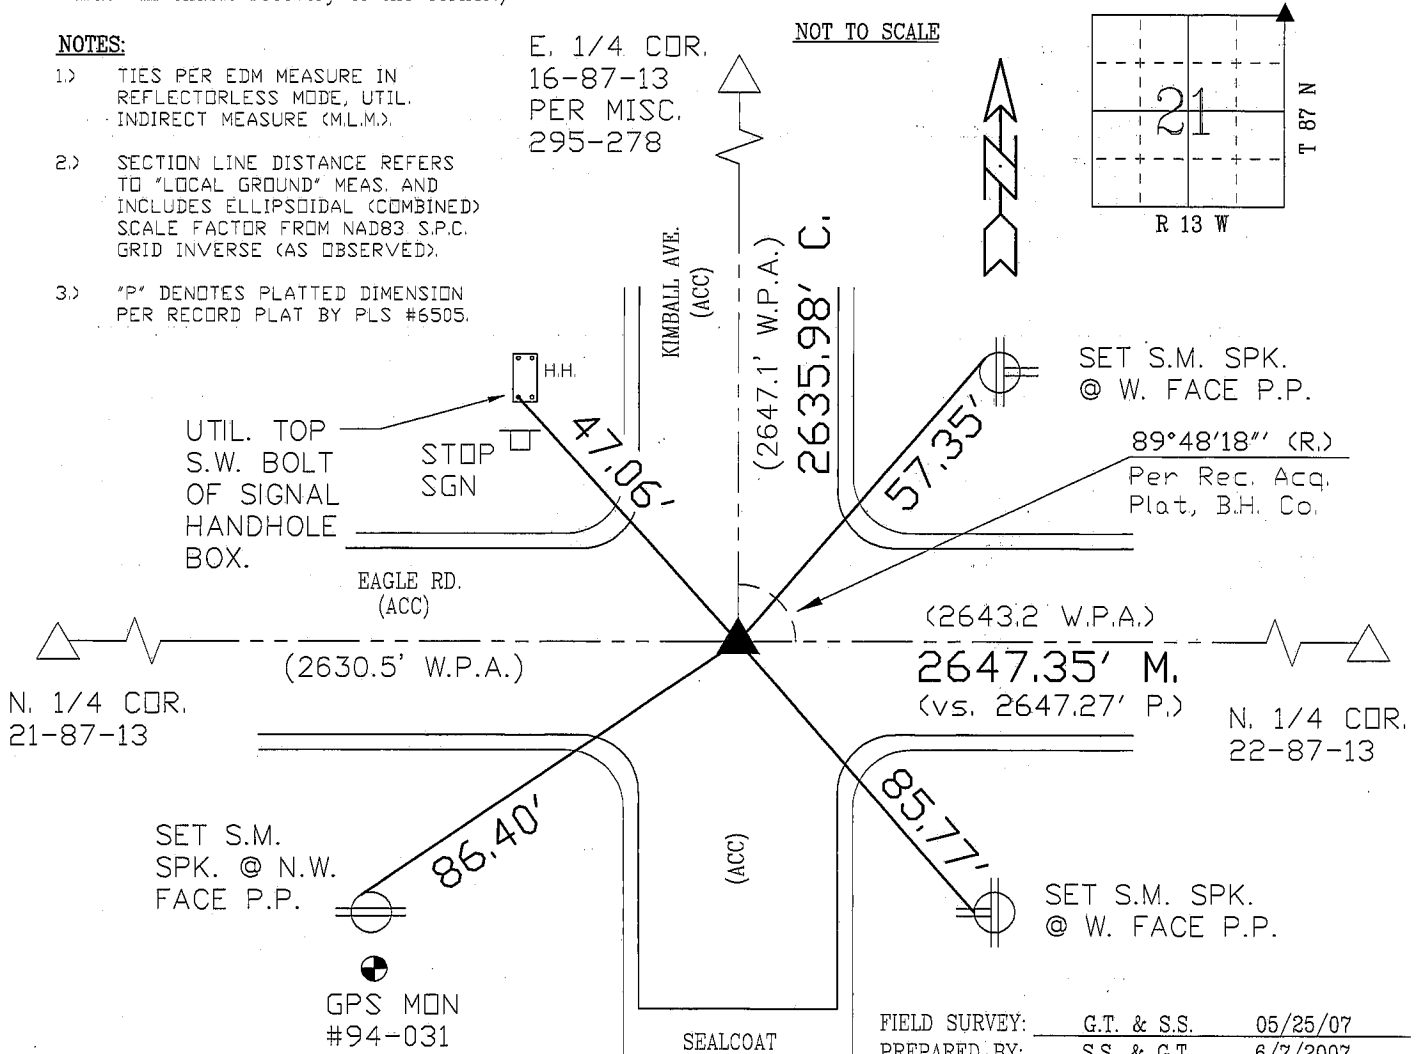

## CERTIFICATION

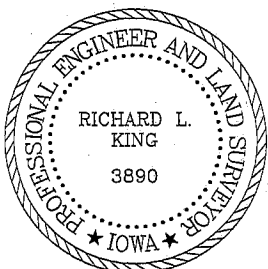

I hereby certify that this land surveying document was prepared and the related survey work was performed by me or under my direct personal supervision and that I am a duly licensed Land Surveyor under the laws of the State of Iowa.

*Richard L. King* 6/19/07  
Richard L. King (date)

License Number 3890

My license renewal date is December 31, 2007

Pages or sheets covered by this seal:

This Land Corner Certificate Only.

## LIST CORNERS TO BE INDEXED

Corner	Section	Township	Range
N.E. COR.	21	87 N	13 W
S.W. COR.	15	87 N	13 W
N.W. COR.	22	87 N	13 W
S.E. COR.	16	87 N	13 W