


Doc ID: 007520010001 Type: GEN Recorded: 12/23/2016 at 10:41:47 Fee Amt: \$7.00 Page 1 of 1 Black Hawk County Iowa SANDIE L. SMITH RECORDER

File 2017-00011697

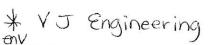



## United States Public Land Survey Corner Certificate of

Land Survey Monuments situated in Section No. \_ \_\_, Township No.\_\_<u>87 North</u> 10 Range No. <u>14 West</u>, of the Fifth Principal Meridian,\_ Black Hawk \_\_\_County, Iowa Previously recorded in \_\_\_\_ File No. 2011-011420 Show reason for preparing this certificate, the evidence and detailed procedures used in establishing the corner positions and monumentation found or placed.) Monument Description and Remarks: West 1/4 Corner, Section 10-T87N-R14W Black Hawk County WPA Field Notes dated Sept. 8th, 1938 state: "Found Limestone 15"x12"x5" and Iron Bar 1/2"x21½" Also Oak Hub 2"x2"x12" very rotten. Lowered Evidence and Set C.M. on top 12" below ground." Cor. Cert. File No. 2011-011420 states: "Found 3/4"Ø rebar (exposed) (1.8' long). Removed said rebar and probed in hole. Believe to have hit a concrete monument (1.75' deep). Cut said rebar to a length of 1.35' and replaced in its original position." Searched area and found called for 3/4"Ø Rebar. This corner certificate is being prepared to update the reference ties.

## PLAN - VIEW

(Show a minimum of three reference ties to durable physical objects, relevant monuments and physical conditions that will enable recovery of the corner.)

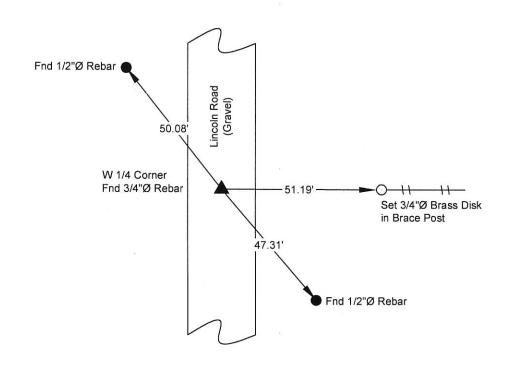

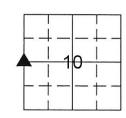

## **LEGEND**

Found Section Corner

Set Section Corner Set 5/8"Ø x 24" Rebar w/ Orange Cap Iowa P.L.S. #22561

Power Pole Fence Line

. Fence Corner

Fence Post Light Pole

Decid. / Conif.

Telephone Pedestal

Concrete Reference



I hereby certify that this land surveying document wa prepared and the related survey work was performed by me or under my direct personal supervision and that I am a duly licensed Land Surveyor under the laws of the State of Iowa

Date

Matthew A. Kofta, P.L.S. License Number 22561

My license renewal date is December 31, 2018

Pages or sheets covered by this seal:

List Corner to be Indexed

Section Corner

Twp

Range

West 1/4

10

87 North

14 West



VJ Engineering 1501 Technology Parkway Cedar Falls, Iowa — 319—266—5829 Section Corner

Reference Ties

file no. 168086 drawn by date

(100)