

Prepared By: Matthew A. Kofta, P.L.S., VJ Engineering, 1501 Technology Parkway, Suite 100, Cedar Falls, Iowa, 50613, (319) 266-5829
Return To: Matthew A. Kofta, P.L.S., VJ Engineering, 1501 Technology Parkway, Suite 100, Cedar Falls, Iowa, 50613, (319) 266-5829

United States Public Land Survey Corner Certificate of


Land Survey Monuments situated in Section No. 19, Township No. 87 North, Range No. 14 West, of the Fifth Principal Meridian, Black Hawk County, Iowa
Previously recorded in N/A

Show reason for preparing this certificate, the evidence and detailed procedures used in establishing the corner positions and monumentation found or placed.

Monument Description and Remarks: East 1/4 Corner -- Section 19 - T87N - R14W
WPA Corner Ties state that a 9"x9"x17" limestone was found and lowered and a C.M. was set on top, 12" below ground.
Plat of Survey File 2014-8213 indicates that a No. 4 Bar w/o ID Cap was found at location.
Searched area and found bent No. 4 Bar, excavated around bar and found concrete monument with brass cap stamped 19 + 20, 0.4' deep.
The bent No. 4 bar is located on the West side of the concrete monument.
Accepted and used the found concrete monument as the corner.
This corner certificate is being prepared as there is not one of record.

PLAN - VIEW

(Show a minimum of three reference ties to durable physical objects, relevant monuments and physical conditions that will enable recovery of the corner.)

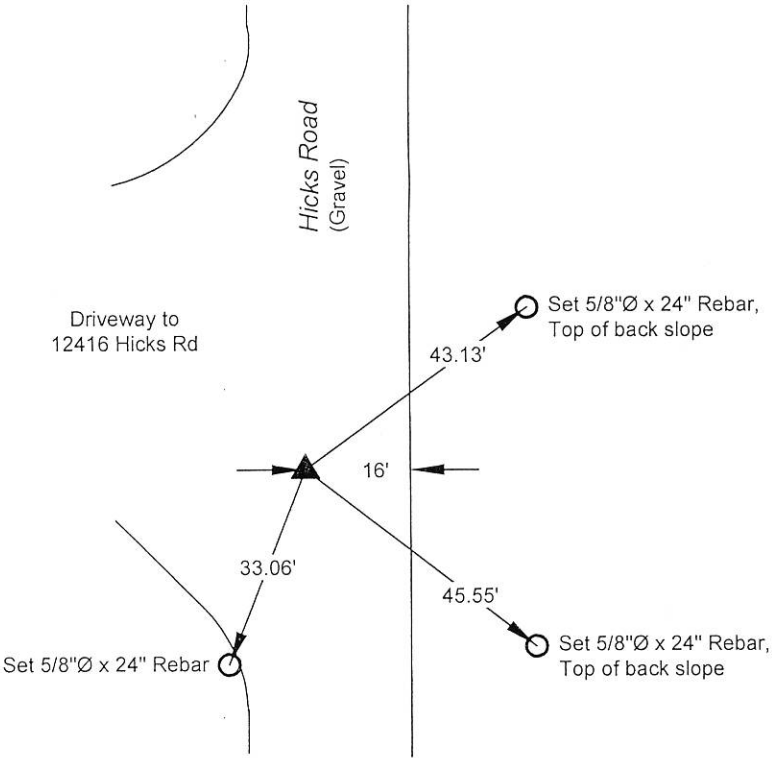

LEGEND

- Found Section Corner
- Set Section Corner
- Set 5/8"Ø x 24" Rebar w/ Orange Cap Iowa P.L.S. #22561
- Power Pole
- Fence Line
- Fence Corner
- Fence Post
- Light Pole
- Trees
- Decid. / Conif.
- Telephone Pedestal
- Concrete Reference Monument

I hereby certify that this land surveying document was prepared and the related survey work was performed by me or under my direct personal supervision and that I am a duly licensed Land Surveyor under the laws of the State of Iowa.



Matthew A. Kofta, P.L.S.
License Number 22561
My license renewal date is December 31, 2020
Pages or sheets covered by this seal: 1

List Corner to be Indexed

Corner	Section	Twp	Range
East 1/4	19	87 N	14 W



VJ Engineering
1501 Technology Parkway
Cedar Falls, Iowa - 319-266-5829

Section Corner
Reference Ties

file no.
198061
drawn by
MAK
date
9/11/19