
INDEX \ FEE BOOK # 2005 06427 BLACK HAWK COUNTY, IOWA:ss PROOF FILED FOR RECORD SEP 9 2004 AT 10:00 A.M. FEE 1-5.00-1.00X COMPARED

__ BLACK HAWK COUNTY RECORDER

PAUL HELLAND

Jeffrey P. Helland, 1107 Technology Parkway, Cedar Falls, Iowa 50613-6951, (319)-266-0161 UNITED STATES PUBLIC LAND SURVEY CORNER CERTIFICATE OF LAND SURVEY MONUMENTS SITUATED IN SECTION NO. 31 , TOWNSHIP NO. 87 NORTH, RANGE NO. 14 WEST OF THE FIFTH PRINCIPAL MERIDIAN, BLACK HAWK _, PAGE PREVIOUSLY RECORDED IN BOOK (SHOW REASON FOR PREPARING THIS CERTIFICATE, THE EVIDENCE AND DETAILED PROCEDURES USED IN ESTABLISHING THE CORNER POSITIONS AND MONUMENTATION FOUND OR PLACED.) MONUMENT DESCRIPTION AND REMARKS: No corner certificate on file. Survey completed in the SE 1/4 of Sec. 31-T87N-R14W. E 1/4 CORNER: Black Hawk County Engineer reference ties dated 9/19/1938 calls for (concrete monument w/brass cap). All reference ties obliterated. Of additional Black Hawk County Engineer reference ties (no date), two ties remain: NW corner of house to the SE and RCP to the NE. Using said two ties intersected tie distances and started excavation. Found concrete monument w/brass cap "31+32", 0.7' deep. Set No. 4 rebar on North edge for magnetic detection. Note large discrepancy between field measurement and W.P.A. chaining notes. PLAN VIEW (SHOW A MINIMUM OF THREE REFERENCE TIES TO DURABLE PHYSICAL OBJECTS, RELEVANT MONUMENTS AND PHYSICAL CONDITIONS THAT WILL ENABLE RECOVERY OF THE CORNER.) 31 (Field entrance) Cut "X" top of 12"Ø RCP (Field entrance) Set 8d nail & shiner W face Cut "X" top of Utility Pole

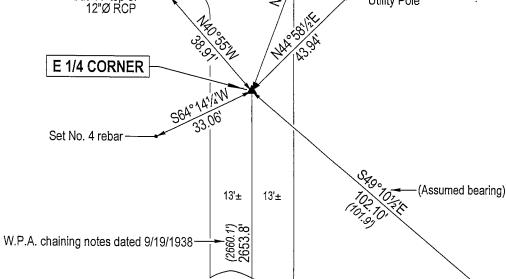

Sec. 31-T87N-R14W
Found ¾"Øx1' long iron pin
above a concrete monument w/brass cap

1107 Technology Parkway Cedar Falls, Iowa 50613-6951

(319)-266-0161

HELLAND ENGINEERING & SURVEYING, LTD.

(00.00') - Per Black Hawk County Engineer ties

File Name: 04-287c1.drg

AWO\

I hereby certify that this land surveying document was prepared and the related survey work was performed by me or under my direct personal supervision and that I am a duly licensed Land

Jeffrey P/Helland License Number 16264 My license renewal date is December 31, 2005.
All pages or sheets are covered by this seal except:

LIST CORNERS TO BE INDEXED CORNER SECTION TOWNSHIP RANGE E 1/4 CORNER 87N 14W

NW Corner of

P.C.C. house foundation