Reserved for County Recorder's

Doc ID: 011877780001 Type: GEN Recorded: 12/13/2022 at 01:59:55 PM Fee Amt: \$7.00 Page 1 of 1 Fee Amt: \$7.00 Page 1 of Black Hawk County Iowa SANDIE L. SMITH RECORDER

File 2023-00008975

Kyle J. Helland, 6109 Chancellor Drive, Cedar Falls, Iowa 50613-6916, (319)-266-0161

UNITED STATES PUBLIC LAND SURVEY CORNER CERTIFICATE

LAND SURVEY MONUMENTS SITUATED IN SECTION NO. _____10___, TOWNSHIP NO.___ 88 NORTH, RANGE

11 WEST OF THE FIFTH PRINCIPAL MERIDIAN, **BLACK HAWK** COUNTY, IOWA.

PREVIOUSLY RECORDED IN

(SHOW REASON FOR PREPARING THIS CERTIFICATE, THE EVIDENCE AND DETAILED PROCEDURES USED IN ESTABLISHING THE CORNER POSITIONS AND MONUMENTATION FOUND OR PLACED.)


MONUMENT DESCRIPTION AND REMARKS:

NO USPLSCC ON FILE. SURVEY COMPLETED IN THE SW 1/4 OF SEC. 2-T88N-R11W.

NE CORNER: WPA NOTES DATED 07/05/1939 CALLS FOR [FOUND LIME STONE 19"x11½"x4" IRON BAR 1"x20¾" LONG, AND REMNANT OF A WOODSTAKE. LOWERED EVIDENCE AND SET C.M. ON TOP 12" DEEP.]. IDOT LAND CORNER SURVEY DATED 10/13/1971 CALLS FOR [FOUND STD. CONC. MONU] IDOT LAND CORNER SURVEY DATED 01/25/1977 CALLS FOR [FOUND IRON PIN OVER STD. CONC. MON.] FOUND NO. 6 REBAR 0.4'± DEEP AND UTILIZED AS CORNER.

PLAN VIEW

(SHOW A MINIMUM OF THREE REFERENCE TIES TO DURABLE PHYSICAL OBJECTS, RELEVANT MONUMENTS AND PHYSICAL CONDITIONS THAT WILL ENABLE RECOVERY OF THE CORNER.)

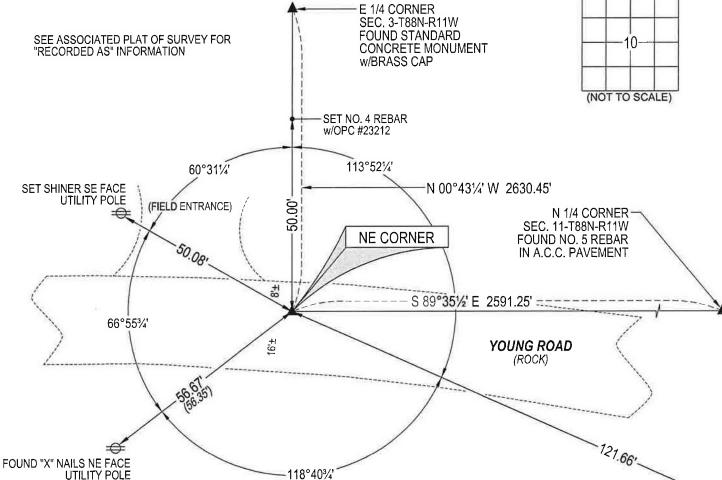

(BEARINGS ARE ASSUMED)

SET SHINER NW FACE UTILITY POLE



HELLAND 23212

AWO1

SURVEY

HELLAND ENGINEERING & SURVEYING, LTD. 6109 Chancellor Drive

Cedar Falls, Iowa 50613-6916 (319)-266-0161

I hereby certify that this land surveying document was prepared and the related survey work was performed by me or under my direct personal supervision and that I am a duly licensed Professional Land Surveyor under the laws of the State of Iowa.

Kyle J/Helland
License Number 23212
My license renewal date is December 31, 2023.
All pages or sheets are covered by this seal except:

BRASS TAG = 4d. NAIL & 13/16"Ø BRASS TAG DRAWN BY: JPH SHINER = 1"Ø STEEL SHINER w/MASONRY NAIL OPC = PLASTIC CAP (O=ORANGE, R=RED, Y=YELLOW) (00') RECORDED AS FILE NAME: 22-261-25.DWG (00') RECORDED AS

LICT CODNEDC TO DE INDEVED			
LIST CORNERS TO BE INDEXED			
CORNER	SECTION	TOWNSHIP	RANGE
NE CORNER	10	88N	11W
SE CORNER	3	88N	11W
SW CORNER	2	88N	11W
NW CORNER	11	88N	11W