

Doc ID: 004594930001 Type: GEN Kind: CORNER Recorded: 10/04/2011 at 12:40:47 PM Fee Amt: \$7.00 Page 1 of 1 Black Hawk County Iowa JUDITH A MCCARTHY RECORDER

F1102012-00006015

**Paul H. Helland, 1107 Technology Parkway, Cedar Falls, Iowa 50613-6951, (319)-266-0161

UNITED STATES PUBLIC LAND SURVEY CORNER CERTIFICATE OF

LAND SURVEY MONUMENTS SITUATED IN SECTION NO. 13, TOWNSHIP NO. 88 NORTH, RANGE

NO. 11 WEST OF THE FIFTH PRINCIPAL MERIDIAN, BLACK HAWK COUNTY, IOWA. PREVIOUSLY RECORDED IN BOOK 2 PAGE 133 (BUCHANAN COUNTY RECORDER'S OFFICE)

(SHOW REASON FOR PREPARING THIS CERTIFICATE, THE EVIDENCE AND DETAILED PROCEDURES USED IN ESTABLISHING THE CORNER POSITIONS AND MONUMENTATION FOUND OR PLACED.)


MONUMENT DESCRIPTION AND REMARKS:

USPLSCC BOOK 2 PAGE 133 MONUMENTATION AND REFERENCE TIES HAVE CHANGED. SURVEY COMPLETED IN THE NE 1/4 OF SEC. 13-T88N-R11W.

- **E 1/4 CORNER:** WPA NOTES DATED 7/13/1939 CALLS FOR *[FOUND NIGGERHEAD 14"x13"x5". LOWERED EVIDENCE AND SET C.M. ON TOP 12" DEEP]*. PLAT OF SURVEY FILE #2003 0026 DATED 12/17/2002 CALLS FOR *[RESET FROM 1939 BLACK HAWK CO. SURVEY NOTES]*. BUCHANAN COUNTY USPLSCC BOOK 2 PAGE 133 DATED 12/26/2002 CALLS FOR *[PLACED 1/2" DIA. REBAR WITH YPC #8812. SEARCH EXTENSIVELY BY EXCAVATING - SEARCH UNSUCCESSFUL]*. PLAT OF SURVEY FILE #2011-00012101 DATED 12/11/2010 CALLS FOR *[FND. 1/2" REBAR/YELLOW PLASTIC CAP NO. 8812 FROM RECORD TIES]*. AFTER A BRIEF SEARCH OF THE AREA, A CONCRETE MONUMENT WITH BRASS CAP WAS FOUND (0.3' DEEP) CORRESPONDING TO WPA NOTES. ALSO FOUND A NO. 4 REBAR W/YPC #8812 6.9' NORTH & 1.15' WEST OF SAID MONUMENT PER BOOK 2 PG 133. UTILIZED SAID CONCRETE MONUMENT AS CORNER.

PLAN VIEW

(SHOW A MINIMUM OF THREE REFERENCE TIES TO DURABLE PHYSICAL OBJECTS, RELEVANT MONUMENTS AND PHYSICAL CONDITIONS THAT WILL ENABLE RECOVERY OF THE CORNER.)

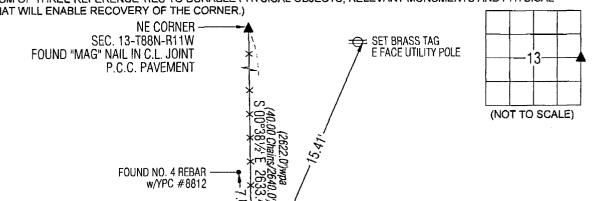

— CENTER SEC, 13-T88N-R11W SET "COTTON GIN SPIKE" IN A.C.C. PAVEMENT

SET BRASS TAG -S FACE RR TIE CORNER POST 1.55'
(1.7')wpa

SET BRASS TAG
W FACE UTILITY POLE

1.34'

\$ 88°41'/2' W 2635.2' (39.80 Chains/2626.8')u (40.00 Chains/2640.0')¢ (2634.11')#

E 1/4 CORNER

LEGEND

(0.0')¢ PER SURVEYOR'S RECORD BOOK 1 (AUDITOR'S OFFICE) PG 227 DATED 9/10/1867

 $(0.0)\!\mu$ per george miller county surveyor's record

(0.0')WPA PER WPA NOTES DATED 5/11/1939 & 7/13/1939

(0.0')# PER PLAT OF SURVEY FILED 12/14/2010-00012101

(BEARINGS ARE ASSUMED)



CINEER

HELLAND 6505

310WA

HELLAND ENGINEERING & SURVEYING, LTD.

1107 Technology Parkway Cedar Falls, Iowa 50613-6951 (319)-266-0161

I hereby certify that this land surveying document was prepared and the related survey work was performed by me or under my direct personal supervision and that I am a duly licensed Land Surveyor under the laws of the State of lowa.

Paul H. Helland License Number 6505 My license renewal date is December 31, 2

Faun H. Hellallu License Number 6505 My license renewal date is December 31, 2011. All pages or sheets are covered by this seal except: SHINER = 8D NAIL & 1 5/16"Ø METAL SHINER
BRASS TAG = 8D NAIL & 13/16"Ø BRASS TAG
OPC = PLASTIC CAP (0=ORANGE, R=RED, Y=YELLOW)
(00') RECORDED AS FILE NAME: 11-217C1.DWG

LIST CORNERS TO BE INDEXED			
CORNER	SECTION	TOWNSHIP	RANGE
E 1/4 CORNER	13	88N	1 1W
W 1/4 CORNER	18	88N	11W