

INDEX

BLACK HAWK COUNTY, IOWA:ss

FEE BOOK # 2003 08091

PROOF

FILED FOR RECORD SEP 25, 2002, AT 10:30 A.M. FEE 1-5.00/.

COMPARED

Robert E. Greenwald


BLACK HAWK COUNTY RECORDER

SHOEMAKER & HAALAND 160 HOLIDAY ROAD CORALVILLE, IA 52241

**Shoemaker
& Haaland**160 HOLIDAY ROAD
CORALVILLE, IOWA 52241
PHONE: (319) 351-7150TITLE SECTION CORNER TIES FOR SECTION 3, T88N, R12W
BLACK HAWK COUNTY, IOWADATE 09/20/02
DRAWN REG
CHECKED REG
APPROVED REG
DRAWING 02166601U.S. PUBLIC LAND SURVEY CORNER CERTIFICATE
OF
LAND SURVEY MOUNMENTS SITUATED IN
SECTION 3 TOWNSHIP 88 NORTH, RANGE 12 WEST,
OF THE FIFTH PRINCIPAL MERIDIAN, BLACK HAWK COUNTY, IOWA

MONUMENT DESCRIPTION AND REMARKS:

Update Section Corner Ties from County Engineer Office in Section Corner Book. Found 1/2"Ø Rebar 3" deep in Asphalt Pavement.

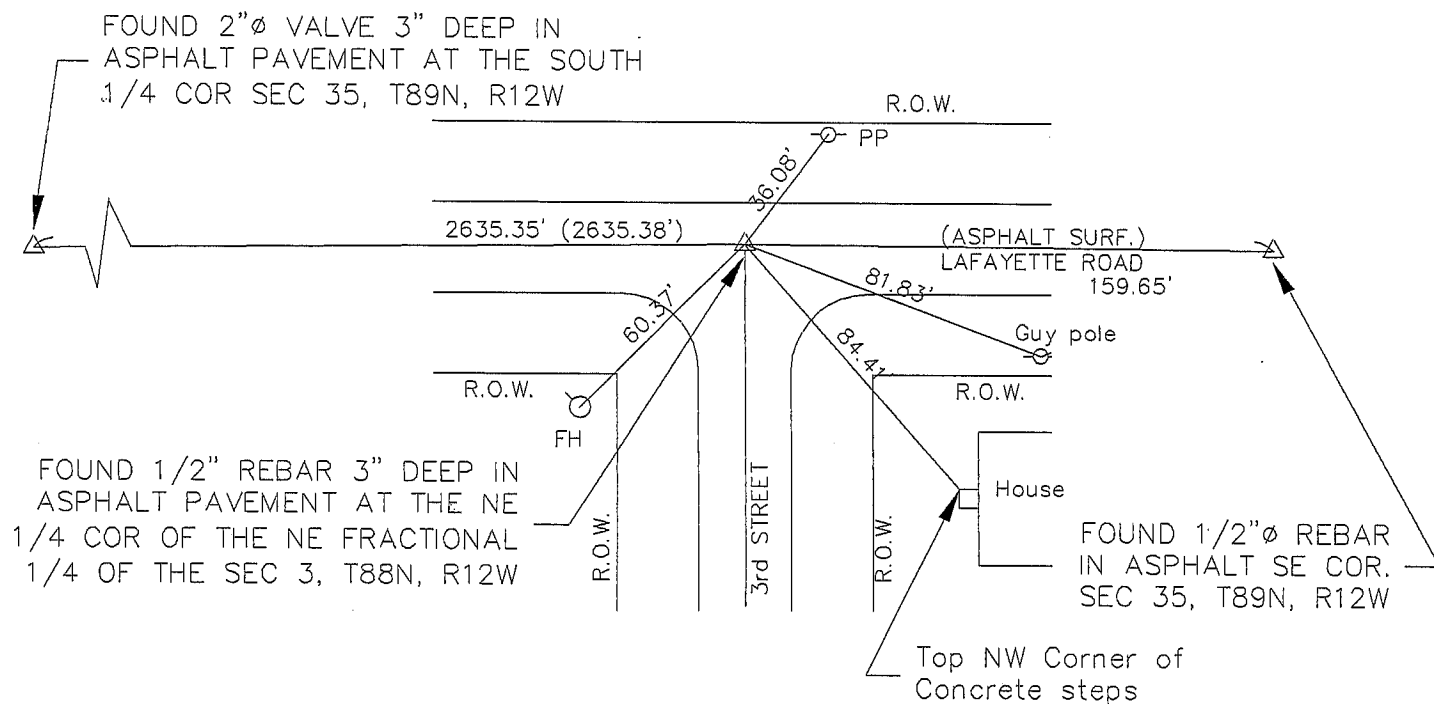


0.00' MEASURED DISTANCE
(0.00) RECORDED DISTANCE
R.O.W. RIGHT OF WAY
PP POWER POLE
FH FIRE HYDRANT

Date of survey, 08/23/02
FOR: CITY OF RAYMOND, IOWA
REQUESTED BY: CITY OF RAYMOND, IOWA

I hereby certify that this land surveying document was prepared and the related survey work was performed by me or under my direct personal supervision and that I am a duly Licensed Land Surveyor under the laws of the State of Iowa.

Robert E. Greenwald 9/23/02
Robert E. Greenwald Date
Registration No. 9175

My license renewal date is December 31, 2002.
All pages or sheets are covered by this seal except:

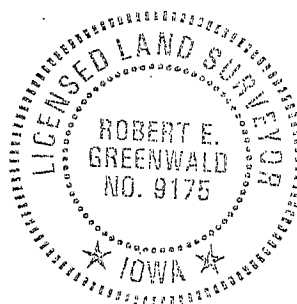

NOT TO SCALE

