HELLAND ENGINEERING & SURVEYING LTD

 ϕ_{I}

Document Number: 2007010121

Date: Nov 01, 2006 2:22:17 pm

Aud Fee:

0.00

Rec Fee: 5.00
Rec Management Fee:

1.00

P

Trans Tax: 0.00 E-Com Fee: 1.00

Non-Standard Page Fee:


0.00

 \mathbf{Z}

Filed for record in Black Hawk County, Iowa

Patricia S. Sass, County Recorder

Paul H. Helland, 1107 Technology Parkway, Cedar Falls, Iowa 50613-6951, (319)-266-0161 UNITED STATES PUBLIC LAND SURVEY CORNER CERTIFICATE LAND SURVEY MONUMENTS SITUATED IN SECTION NO. 7 _, TOWNSHIP NO. 88 NORTH, RANGE __WEST OF THE FIFTH PRINCIPAL MERIDIAN,_ BLACK HAWK COUNTY, IOWA. PREVIOUSLY RECORDED IN (SHOW REASON FOR PREPARING THIS CERTIFICATE, THE EVIDENCE AND DETAILED PROCEDURES USED IN ESTABLISHING THE CORNER POSITIONS AND MONUMENTATION FOUND OR PLACED.) MONUMENT DESCRIPTION AND REMARKS: NO USPLSCC ON FILE. SURVEY COMPLETED IN THE SE 1/4 SW 1/4 OF SEC. 7-T88N-R12W. NE CORNER SE 1/4 SW 1/4: NO BLACK HAWK COUNTY ENGINEER REFERENCE TIES AVAILABLE. MINOR PLAT FEE BK # 2005-00854 CALLS FOR [FOUND 1" CLIP PIN]. FOUND 1" PINCH PIPE EXPOSED. POSITION CORRESPONDS TO SAID MINOR PLAT. PLAN VIEW (SHOW A MINIMUM OF THREE REFERENCE TIES TO DURABLE PHYSICAL OBJECTS, RELEVANT MONUMENTS AND PHYSICAL CONDITIONS THAT WILL ENABLE RECOVERY OF THE CORNER.) (0.0')B PER "CEDAR TERRACE 3RD ADDITION" (DATED 4/10/1964) (REFERENCE ONLY) (0.0')¶ PER AUDITOR'S SURVEY BK 1 PG 327 (DATED 6/17/1868) (0.0')§ PER GEORGE W. MILLER SURVEY RECORD'S BOOK (DATED 4/11/1857) (0.0')£ PER SKETCH OF SURVEY 74 MISC. 647 (DATED 6/10/1952) (NOT TO SCALE) SET SHINER S FACE **UTILITY POLE**

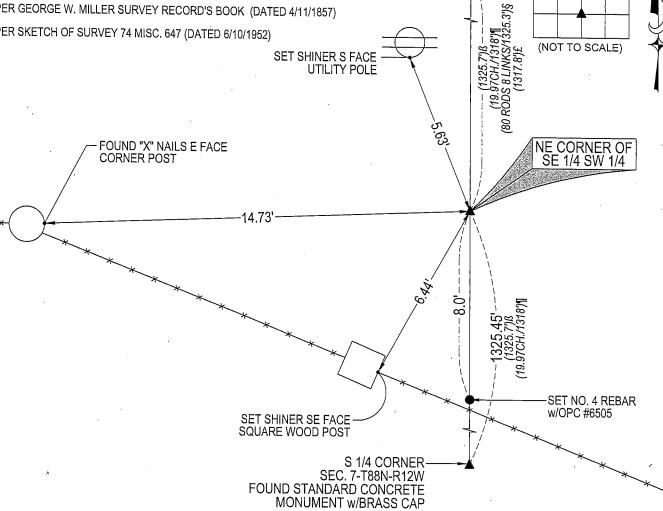

HES

HELLAND ENGINEERING & SURVEYING, LTD.

1107 Technology Parkway Cedar Falls, Iowa 50613-6951 (319)-266-0161 SHINER = 8D NAIL & 1 15/16"Ø METAL SHINER OPC = PLASTIC CAP (O=ORANGE, R=RED, Y=YELLOW)

LIST CORNERS TO BE INDEXED

(00') RECORDED AS

FILE NAME: 06-277C1.DWG

PAUL H. 6505 600 7/OWA

I hereby certify that this land surveying document was prepared and the related survey work was performed by me or under my direct personal supervision and that I am a duly licensed Land Surveyor under the laws of the State of Iowa.

Paul H. Helland
License Mumber 6505

License Number 6505
My license renewal date is December 31, 2007.
All pages or sheets are covered by this seal except:

CORNER
NE CORNER
SE 1/4 SW 1/4

Fange 7 88N 12W