Doc ID: 005650060001 Type: GEN Recorded: 12/31/2014 at 08:33:47 AM Fee Amt: \$7.00 Page 1 of 1 Black Hawk County Iowa SANDIE L. SMITH RECORDER


File 2015-00010641


UNITED STATES PUBLIC LAND SURVEY CORNER CERTIFICATE

OH

PLAN - VIEW

(Show a minimum of three reference ties to durable physical objects, relevant monuments and physical conditions recovery of the corner.)

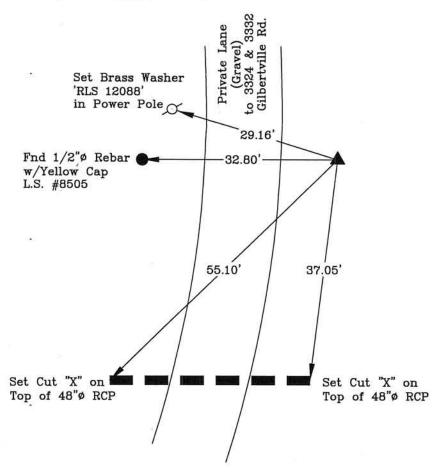

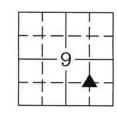

SECTION CORNER

LEGEND

FOUND

SECTION CORNER
SET

SET 5/8"ø x 24"
REBAR W/RED CAP
IA LIC #12088

POWER POLE
FENCE LINE

FENCE CORNER FOUND

FENCE POST

- LIGHT POLE

TREES DECID./CONIF.

TELEPHONE PED.

CONC. REF. MONUMENT

I hereby certify that this land surveying document was prepared and the related survey work was performed by me or under my direct personal supervision and that I am a duly licensed Land Surveyor under the laws of the State of lowa.



WENDELL J. LUPKES, L.S. DATE

License number 12088
My license renewal date is December 31, 2014
Pages or sheets covered by this seal:

List Corner to be Indexed

Corner Section Twp Range
NE Cor. 09 88 N 12 W
SW 1/4
SE 1/4



VJ Engineering 1501 Technology Parkway Cedar Falls, Iowa - 319-266-5829

SECTION CORNER
REFERENCE TIES

scale NONE drawn by MAK date

11/24/