Number: 202400005814

Recorded: 11/1/2023 at 10:02:40.0 AM

County Recording Fee: \$7.00 Iowa E-Filing Fee: \$3.00 Combined Fee: \$10.00

Revenue Tax:

Sandie L. Smith, RECORDER Black Hawk County, Iowa

ed by & Return to: Isaiah M. Reicks, HRS, LLC, 2206 East Bremer Avenue, Waverly, IA 50677, Phone 319-483-5187

United States Public Land Survey Corner Certificate

Land Survey Monument situated in

Section 33, Township 88 North, Range 12 West of the Fifth Principal Meridian, Black Hawk County, Iowa. On file in **Document #2003-07845** in the County Recorder's Office.

This certificate is being prepared in compliance with Iowa Code Chapter 355.11 because:

There is no certificate on file for this corner. There are no longer three valid ties of record. There are changes to reference ties of record. There is change of monumentation of record. To clarify description of record monument (ties).


Monument Description and Remarks:

Center of Section:

Found 5/8"Ø Rebar w/Yellow Plastic Cap PLS 3890 with information obtained from the previously recorded Section Corner Certificate.

Plan View - Not to Scale

(Show a minimum of three reference ties to durable physical objects, relevant monuments and physical conditions that will enable recovery of the corner.)

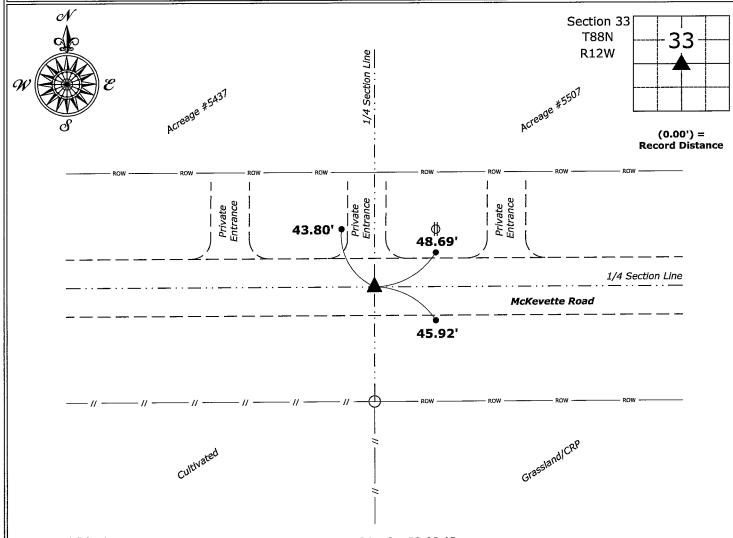

= Set 5/8"Ø Rebar at the Edge of Shoulder Inline with Power Pole

REICKS

Center of Section 33-88-12 Found 5/8"Ø Rebar w/Yellow Plastic Cap PLS 3890

I hereby certify that this land surveying document was prepared and the related survey work was performed by me or under my direct personal supervision and that I am a duly licensed Land Surveyor under the laws of the State of Iowa.

Isaiah M. Reicks M. 10-31-23 Date:

License number 22468

My license renewal date is December 31, 2023. Sheets covered by this seal: Individual sheet only

Project Number: 2023-564 FB:Black Hawk 11, Page(s) 22

List Corner to be Indexed

Section

33

Corner

CTR

Township

88

Range

12

Projects - WO\County Control Systems_WO\BLACK HAWK\BHCO-23\BHCO-23-2023.dwg, 10/31/2023 3:31:05 PM