Document Number: 2007013542

Date: Dec 15, 2006 4:30:00 pm

0.00

1.00

Aud Fee:

Trans Tax:

Rec Fee: 5.00

COUNTY, IOWA.

1.00

E-Com Fee:

0.00

Rec Management Fee: Non-Standard Page Fee:

0.00

 $\mathbf{Z}$ 

Filed for record in Black Hawk County, Iowa

Patricia S. Sass, County Recorder

Paul H. Helland, 1107 Technology Parkway, Cedar Falls, Iowa 50613-6951, (319)-266-0161

## UNITED STATES PUBLIC LAND SURVEY CORNER CERTIFICATE OF

LAND SURVEY MONUMENTS SITUATED IN SECTION NO.\_\_\_ 16 , TOWNSHIP NO. 88 NORTH, RANGE NO. 13 WEST OF THE FIFTH PRINCIPAL MERIDIAN, BLACK HAWK

PREVIOUSLY RECORDED IN


(SHOW REASON FOR PREPARING THIS CERTIFICATE, THE EVIDENCE AND DETAILED PROCEDURES USED IN ESTABLISHING THE CORNER POSITIONS AND MONUMENTATION FOUND OR PLACED.)

MONUMENT DESCRIPTION AND REMARKS:

NO USPLSCC ON FILE. SURVEY COMPLETED IN THE NW 1/4 OF SEC. 15-T88N-R13W.

NE CORNER: ALL BLACK HAWK COUNTY ENGINEER REFERENCE TIES OBLITERATED. FOUND 3"Ø ALUMINUM DISC IN P.C.C. PAVEMENT.

## PLAN VIEW (SHOW A MINIMUM OF THREE REFERENCE TIES TO DURABLE PHYSICAL OBJECTS, RELEVANT MONUMENTS AND PHYSICAL CONDITIONS THAT WILL ENABLE RECOVERY OF THE CORNER.)

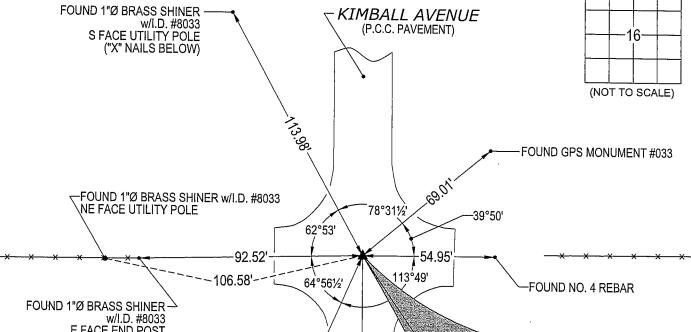

w/l.D. #8033 E FACE END POST **NE CORNER** 10'± 10'± (2647.65')WPA S 00°371¼' W 2647.0'

W 1/4 CORNER SEC. 15-T88N-R13W FOUND 3"Ø ALUMINUM DISC FOUND 1"Ø BRASS SHINER IN P.C.C. PAVEMENT PER 343 MISC. 351

(BEARINGS ARE ASSUMED)

HELLAND ENGINEERING & SURVEYING, LTD. 1107 Technology Parkway Cedar Falls, Iowa 50613-6951

I hereby certify that this land surveying document was prepared and the related survey work was performed by me or under my direct personal supervision and that I am a duly licensed Land Surveyor under the laws of the State of Iowa.

Paul H. Heiland
License Number 6505
My license reposed data is 5

SHINER = 8D NAIL & 1 15/16"Ø METAL SHINER OPC = PLASTIC CAP (O=ORANGE, R=RED, Y=YELLOW)

(00') RECORDED AS FILE NAME: 06-295C1.DWG

LIST CORNERS TO BE INDEXED CORNER SECTION TOWNSHIP **RANGE** 

**NE CORNER** 16 13W 88N

Rec



w/l.D. #8033 NE FACE UTILITY POLE

(319)-266-0161

My license renewal date is December 31, 2007.
All pages or sheets are covered by this seal except: