HELLAND ENGINEERING & SURVEYING LTD

Document Number: 2007010992

Date: Nov 13, 2006 4:30:00 pm

Aud Fee: Trans Tax: 0.00

Rec Fee:

1.00 0.00


 $\mathbf{Z}$ 

Rec Management Fee: 1.00 Non-Standard Page Fee:

Filed for record in Black Hawk County, Iowa Patricia S. Sass, County Recorder

0.00

## Jeffrey P. Helland, 1107 Technology Parkway, Cedar Falls, Iowa 50613-6951, (319)-266-0161 UNITED STATES PUBLIC LAND SURVEY CORNER CERTIFICATE LAND SURVEY MONUMENTS SITUATED IN SECTION NO. 34 , TOWNSHIP NO. 88 NORTH, RANGE 13 \_WEST OF THE FIFTH PRINCIPAL MERIDIAN, BLACK HAWK COUNTY, IOWA. PREVIOUSLY RECORDED IN (SHOW REASON FOR PREPARING THIS CERTIFICATE, THE EVIDENCE AND DETAILED PROCEDURES USED IN ESTABLISHING THE CORNER POSITIONS AND MONUMENTATION FOUND OR PLACED.) MONUMENT DESCRIPTION AND REMARKS: NO USPLSCC ON FILE. SURVEY COMPLETED IN THE SW 1/4 OF SEC. 34-T88N-R13W. CENTER: NO BLACK HAWK COUNTY ENGINEER REFERENCE TIES AVAILABLE. LAND CORNER SURVEY FOR PROJECT BLACKHAWK CO. F-1091(1) DATED 5/19/1958 DOES NOT REFERENCE CORNER. R.O.W. DESCRIPTION LAND DEED BOOK 543 PAGE 303 SHOWS THE CENTER AT STA. 2269+33. FOUND TWO R.O.W. RAILS TO THE WEST AND ONE R.O.W. RAIL AND ONE NO. 5 REBAR W/ALUMINUM IDOT CAP TO THE EAST. A BEST FIT LINE USING THESE FOUR MONUMENTS WAS USED TO ESTABLISHED THE CENTER'S NORTHING ON A STRAIGHT LINE BETWEEN THE N 1/4 CORNER AND THE S 1/4 CORNER SET NO 4 REBAR W/OPC #16264. CORNER'S LINE BETWEEN THE N 1/4 CORNER AND THE S 1/4 CORNER. SET NO. 4 REBAR W/OPC #16264. CORNER'S POSITION CORRESPONDS TO ROAD STATIONING FROM THE N 1/4 CORNER. PLAN VIEW (SHOW A MINIMUM OF THREE REFERENCE TIES TO DURABLE PHYSICAL OBJECTS, RELEVANT MONUMENTS AND PHYSICAL CONDITIONS THAT WILL ENABLE RECOVERY OF THE CORNER.) SET SHINER S FACE UTILITY POLE N 1/4 CORNER 34-T88N-R13W FOUND NO. 5 REBAR PER R.O.W. STATIONING 34 543 LD 301-303

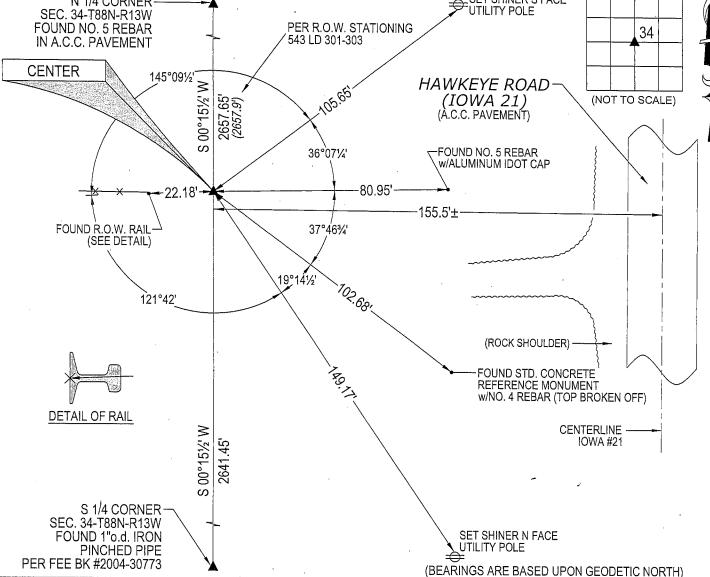

JEFFREY P. HELLAND

AWO1

SURVEY

HELLAND ENGINEERING & SURVEYING, LTD.

1107 Technology Parkway Cedar Falls, Iowa 50613-6951 (319)-266-0161

I hereby certify that this land surveying document was prepared and the related survey work was performed by me or under my direct personal supervision and that I am a duly licensed Land Surveyor under the laws of the State of lowa. elland 11/01/06

offrey,P/Helland cense Number 16264

license renewal date is December 31, 2007. All pages or sheets are covered by this seal except: SHINER = 8D NAIL & 1 15/16"Ø METAL SHINER OPC = PLASTIC CAP (O=ORANGE, R=RED, Y=YELLOW)

(00') RECORDED AS

FILE NAME: 06-284C1.DWG

SECTION TOWNSHIP RANGE

