

Doc ID: 005634350001 Type: GEN Recorded: 12/05/2014 at 12:02:17 PN Fee Amt: \$7.00 Page 1 of 1 Black Hawk County Iowa JUDITH A MCCARTHY RECORDER

File 2015-00009465

Prepared by & Return to: Herold - Reicks Surveying, 10 East Main Street, New Hampton, IA 50659, Ph. 641-394-2725

UNITED STATES PUBLIC LAND SURVEY CORNER CERTIFICATE

Land Survey Monuments situated in Section **36**, Township **88** North, Range **13** West of the Fifth Principal Meridian, **Black Hawk** County, Iowa. **1.)** Previously recorded in Doc. #2007-005867 in the County Recorder's office. **2.)** Previously recorded in Doc. #2007-005865 in the County Recorder's office.

This certificate is being prepared in compliance with Iowa Code Chapter 355.11 because:


☐ There is no certificate on file for this corner.
☐ There are no longer three valid ties of record.
☐ There are changes to reference ties of record.
☐ There is change of monumentation of record.
☐ To clarify description of record monument (ties).

Monument Description and Remarks:

- 1.) Southeast Corner: Set 1"Ø Bronze Survey Marker PLS 19211 at previous location (Found 5/8"Ø Rebar) by means of coordinates obtained prior to highway reconstruction, Project No. FM-TSF-C007(130)--5B-07.
- 2.) Northeast Corner SE 1/4 SE 1/4: Set 1"Ø Bronze Survey Marker PLS 19211 at previous location (Found PK Nail w/Stainless Steel Washer PLS 16775) by means of coordinates obtained prior to highway reconstruction, Project No. FM-TSF-C007(130)--5B-07.

PLAN - VIEW

(Show a minimum of three reference ties to durable physical objects, relevant monuments and physical conditions that will enable recovery of the corner.)

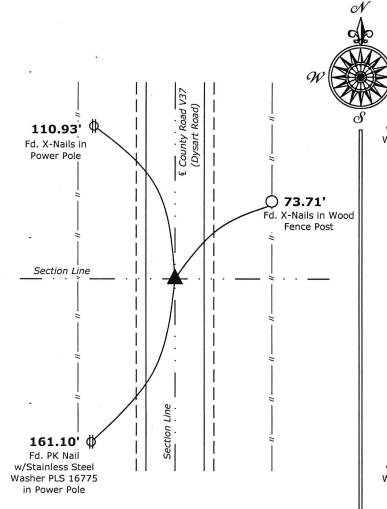

1.) Southeast Corner Section 36-88-13

Set 1"Ø Bronze Survey Marker PLS 19211

Sec. 36 T88N **R13W** 36 £ County Road V37 (Dysart Road) 188.21' Fd. PK Nail Orange Twp. w/Stainless Steel Washer PLS 16775 in Power Pole 50.74 Fd. PK Nail w/Stainless Steel Washer in Top Center of Wood Cor. Post 1/4-1/4 Section Line 33.00 Fd. 1/2"Ø Rebar w/Red Plastic Cap PLS 16775 49.14' Fd. PK Nail w/Stainless Steel Washer PLS 16775 in Power Pole

2.) Northeast Corner SE 1/4 - SE 1/4 Section 36-88-13
Set 1"Ø Bronze Survey Marker PLS 19211

KIRK D. REICKS 19211

I hereby certify that this land surveying document was prepared and the related survey work was performed by me or under my direct personal supervision and that I am a duly licensed Land Surveyor under the laws of the State of Iowa.

Kirk D. Meithe 12 Kirk D. Reicks

License number 19211 My license renewal date is December 31, 2014. Sheets covered by this seal: Individual sheet only

Date:

List Corners to be Indexed				
Corr	ners S	Section	Twp.	Range
S	E	36	88	13
NE-S	E-SE	36	88	13

Project Number: 2014-135 FB: Black Hawk County 1, Pg. 17