INDEXS MARGIN PROOF COMPARE BLACK HAWK COUNTY IOWA:SS Filed for record $\underline{\text{Mar } 27}$, 2000 at 4:00 P.M. and recorded in Book

Page

Recorder

019959


Fee 1-5.00/


VAN WINKLE-JACOB ENGINEERING, INC 6221 CHANCELLOR DR CEDAR FALLS IA 50613

UNITED STATES PUBLIC LAND SURVEY CORNER CERTIFICATE OF 25 88 N Land Survey Monuments situated in Section -, Township — -. Range ____, of the Fifth Principal Meridian, ____BLACKHAWK __ County, Iowa Previously recorded in Book ., Page _ Show reason for preparing this certificate, the evidence and detailed procedures used in establishing the corner positions and monumentation found or placed.) N 1/4 - FOUND 5/8" REBAR ON CENTERLINE Monument Description and Remarks: _ OF WEST WASHBURN ROAD, 4" DEEP. NO CORNER CERTIFICATE PREVIOUSLY RECORDED.

PLAN - VIEW

(Show a minimum of three reference ties to durable physical objects, relevant monuments and physical conditions recovery of the corner.)

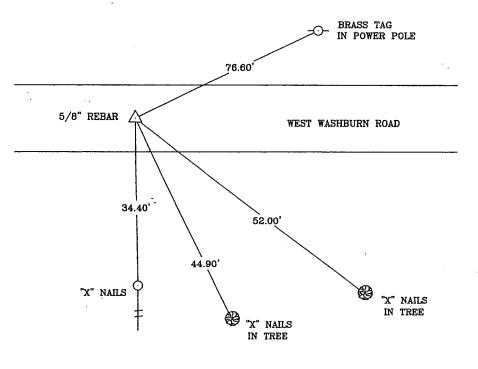

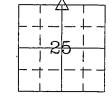

LEGEND

SECTION CORNER Δ FOUND ---POWER POLE FENCE LINE

SECTION CORNER FOUND 0 FENCE POST

LIGHT POLE

TELEPHONE PED.

TREE

I hereby certify that the survey work was completed and this certificate was prepared by me or under my direct personal supervision and that I am a duly registered land surveyor under the laws of the state of lows.

Wendell J. Luphes 3-27-00

REGISTERED LAND SURVEYOR NO.



List Corners to be Indexed

Section 25 Corners N(1/4)

Twp 88

T

an Winkle - Jacob Engineering, Inc. 6221 CHANCELLOR DRIVE CEDAR FALLS, IOWA - 319-266-5829

SECTION CORNER REFERENCE TIES

SCALE SCALE DRAWN BY DATE