INDEX F BLACK HAWK COUNTY, IOWA:ss

FEE BOOK # 2003 30862

PROOF

FILED FOR RECORD

2003 . AT <u>4:00Р.</u>м.

 $fee_{1-5.00/.}$

COMPARED

BLACK HAWK COUNTY RECORDER

HELLAND ENGINEERING & SURVEYING LTD

Paul H. Helland, 1107 Technology Parkway, Cedar Falls, Iowa 50613-6951, (319)-266-0161

UNITED STATES PUBLIC LAND SURVEY CORNER CERTIFICATE

LAND SURVEY MONUMENTS SITUATED IN SECTION NO. 12 , TOWNSHIP NO. 89 11 _WEST OF THE FIFTH PRINCIPAL MERIDIAN, BLACK HAWK COUNTY, IOWA.

PREVIOUSLY RECORDED IN BOOK

(SHOW REASON FOR PREPARING THIS CERTIFICATE, THE EVIDENCE AND DETAILED PROCEDURES USED IN ESTABLISHING THE CORNER POSITIONS AND MONUMENTATION FOUND OR PLACED.)


MONUMENT DESCRIPTION AND REMARKS:

31.8'±

NO CORNER CERTIFICATE ON FILE. SURVEY DONE IN SWFRL 1/4 NWFRL 1/4 OF SEC. 7-T89N-R10W.

- NE CORNER: ALL OF BLACK HAWK COUNTY ENGINEER REFERENCE TIES DATED 8/28/1939 ARE OBLITERATED. ALL BUCHANAN COUNTY ENGINEER REFENCE TIES ARE OBLITERATED. PER TIES DATED 8/28/1939 NOTHING WAS FOUND @ CORNER, IT WAS REESTABLISHED AND A CONCRETE MONUMENT WAS SET 12" DEEP. EXTENSIVE EXCAVATION WAS PERFORMED BY HES IN 1976 FOR C.M. AFTER RUNNING IN CHAINING DISTANCES FROM THE NORTH & THE SOUTH, BELIEVE INSTALLATION OF CONCRETE WINGWALL OBLITERATED CONCRETE MONUMENT. IN 1976 FOUND WOOD CORNER POST 4.0' DEEP AND SET NO. 4 REBAR w/ORANGE CAP #6505 ABOVE. FOUND SAID NO. 4 REBAR W/ORANGE PLASTIC CAP #6505 0.6' DEEP.
- NE CORNER OF SE 1/4 NE 1/4: SET NO. 4 REBAR W/ORANGE PLASTIC CAP #6505 @ MIDPOINT BETWEEN NE CORNER & E 1/4 CORNER OF SEC. 12, 0.5' DEEP IN CULTIVATED FIELD. PLAN VIEW

(SHOW A MINIMUM OF THREE REFERENCE TIES TO DURABLE PHYSICAL OBJECTS, RELEVANT MONUMENTS AND PHYSICAL CONDITIONS THAT WILL ENABLE RECOVERY OF THE CORNER.)

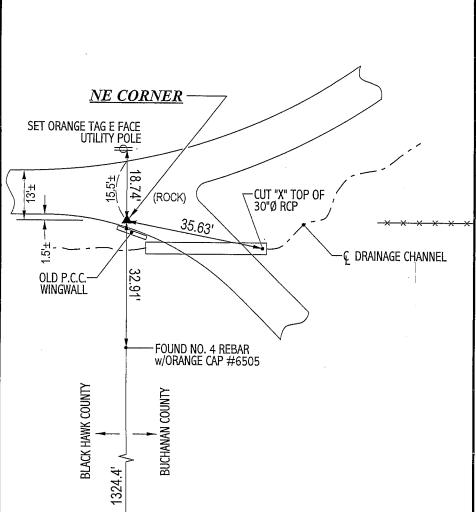

12 BLACK HAWK COUNTY 14'± $2.5' \pm$ CORNER OF SE 1/4 NE (GRASS) 673.0' (673.9')(CULTIVATED FIELD) (CULTIVATED FIFLD) 50 (GRASS) FOUND NO. 4 REBAR w/ORANGE CAP #6505 (CULTIVATED FIELD) SET ORANGE TAG NW FACE UTILITY POLE E 1/4 CORNER

ENGINEER

HÉLLAND

6505

AWO1

PROFESSION

HELLAND ENGINEERING & SURVEYING, LTD.

1107 Technology Parkway

Cedar Falls, Iowa 50613-6951

NE CORNER OF SE 1/4 NE 1/4

(319)-266-0161

I hereby certify that this land surveying document was prepared and the related survey work was performed by me or under my direct personal supervision and that I am a duly licensed Land

Paul H. Helland License Number 6505

My license renewal date is December 31, 2003. All pages or sheets are covered by this seal except: (00.0') - RECORDED AS

FILE NAME: 03-147C4.DRG

LIST CORNERS TO BE INDEXED CORNER SECTION TOWNSHIP

NE CORNER 12 89N 11W

NE CORNER 89N 12. 11W SE 1/4 NE 1/4