

Kind: CORNER
Recorded: 03/09/2010 at 01:48:33 PM
Fee Amt: \$9.00 Page 1 of 1
Black Hawk County Iowa
JUDITH A MCCARTHY RECORDER

File 2010-00016686


## UNITED STATES PUBLIC LAND SURVEY CORNER CERTIFICATE


OF

Land Survey Monuments situated in Section
Show reason for preparing this certificate, the evidence and detailed procedures used in establishing the corner positions and monumentation found or placed.)
Monument Description and Remarks: <u>NW Cor. of the SE. Qtr. of the SE Qtr.</u> Set §" rebar with red plastic cap #12088 at the center of the Southeast Quarter at the intersection
of lines between opposite 1/16 corners.
No Corner Certificate Previously Recorded

## PLAN - VIEW

(Show a minimum of three reference ties to durable physical objects, relevant monuments and physical conditions recovery of the corner.)

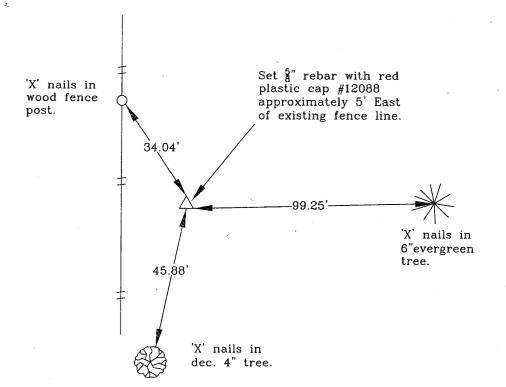

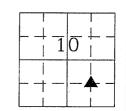

**LEGEND** 

$\triangle$	SECTION CORNER SET
-0-	POWER POLE
<del></del>	FENCE LINE
	FENCE CORNER FOUND
0	FENCE POST
	LIGHT POLE
	TREE
T	TELEPHONE

PED. CONC. REF.

MONUMENT

I hereby certify that this land surveying document was prepared and the related survey work was performed by me or under my direct personal supervision and that I am a duly licensed Land Surveyor under the laws of the State of lowa.



WENDELL S. LUPKES, L.S.

License number 12088 My license renewal date is December 31, 2010 Pages or sheets covered by this seal: \_

List Corner to be Indexed

Corner NW Corner

Section Twp 10 89 N

Range 12 W

SE Qtr. SE Qtr.

SECTION CORNER

scale

N

REFERENCE TIES



VJ Engineering 1501 Technology Parkway Cedar Falls, Iowa — 319—266—5829

drawn by