

Index Legend	
County:	Black Hawk
Section(s):	19 Township: 89 N Range: 12 W
Corner(s):	North 1/4 Corner
*Requestor:	City of Waterloo
Proprietor:	City of Waterloo
Surveyor:	William W. Castle
Surveyor Company:	City of Waterloo Engineering Department 715 Mulberry Street, Waterloo, IA 50703
Return To:	715 Mulberry St, Waterloo, IA 50703 291-4312



Doc ID: 012056980001 Type: GEN
Recorded: 01/03/2024 at 04:08:15 PM
Fee Amt: \$7.00 Page 1 of 1
Black Hawk County Iowa
SANDIE L. SMITH RECORDER

File2024-00008557


United States Public Land Survey Corner Certificate


Land Survey Monument situated in Section 19, Township 89 North, Range 12 West, of the Fifth Principal Meridian, Black Hawk County, Iowa.
Previously recorded in Doc. No. 2007-12982 and Misc Book 299, Page 381 in the Black Hawk County Recorder's Office.

Reason for preparing this certificate, the evidence and detailed procedures used in establishing the corner position, and monumentation found or placed.
Pavement overlain as part of the City of Waterloo's FY2023 Asphalt Overlay Program, Contract No. 1073. Previous certificates noted corner lies on sanitary manhole cover and notches were placed on the casting rim to allow recovery of corner. Prior to construction, found that the sanitary manhole casting and boxout had been replaced. After construction, used project control and survey filed as Doc. No. 2007-12978 to cut new notches on manhole casting rim. Since corner falls on manhole cover, no monument was set at actual corner.

PLAN VIEW

Show a minimum of three reference ties to durable physical objects, relevant monuments and physical conditions that will enable recovery of the corner.

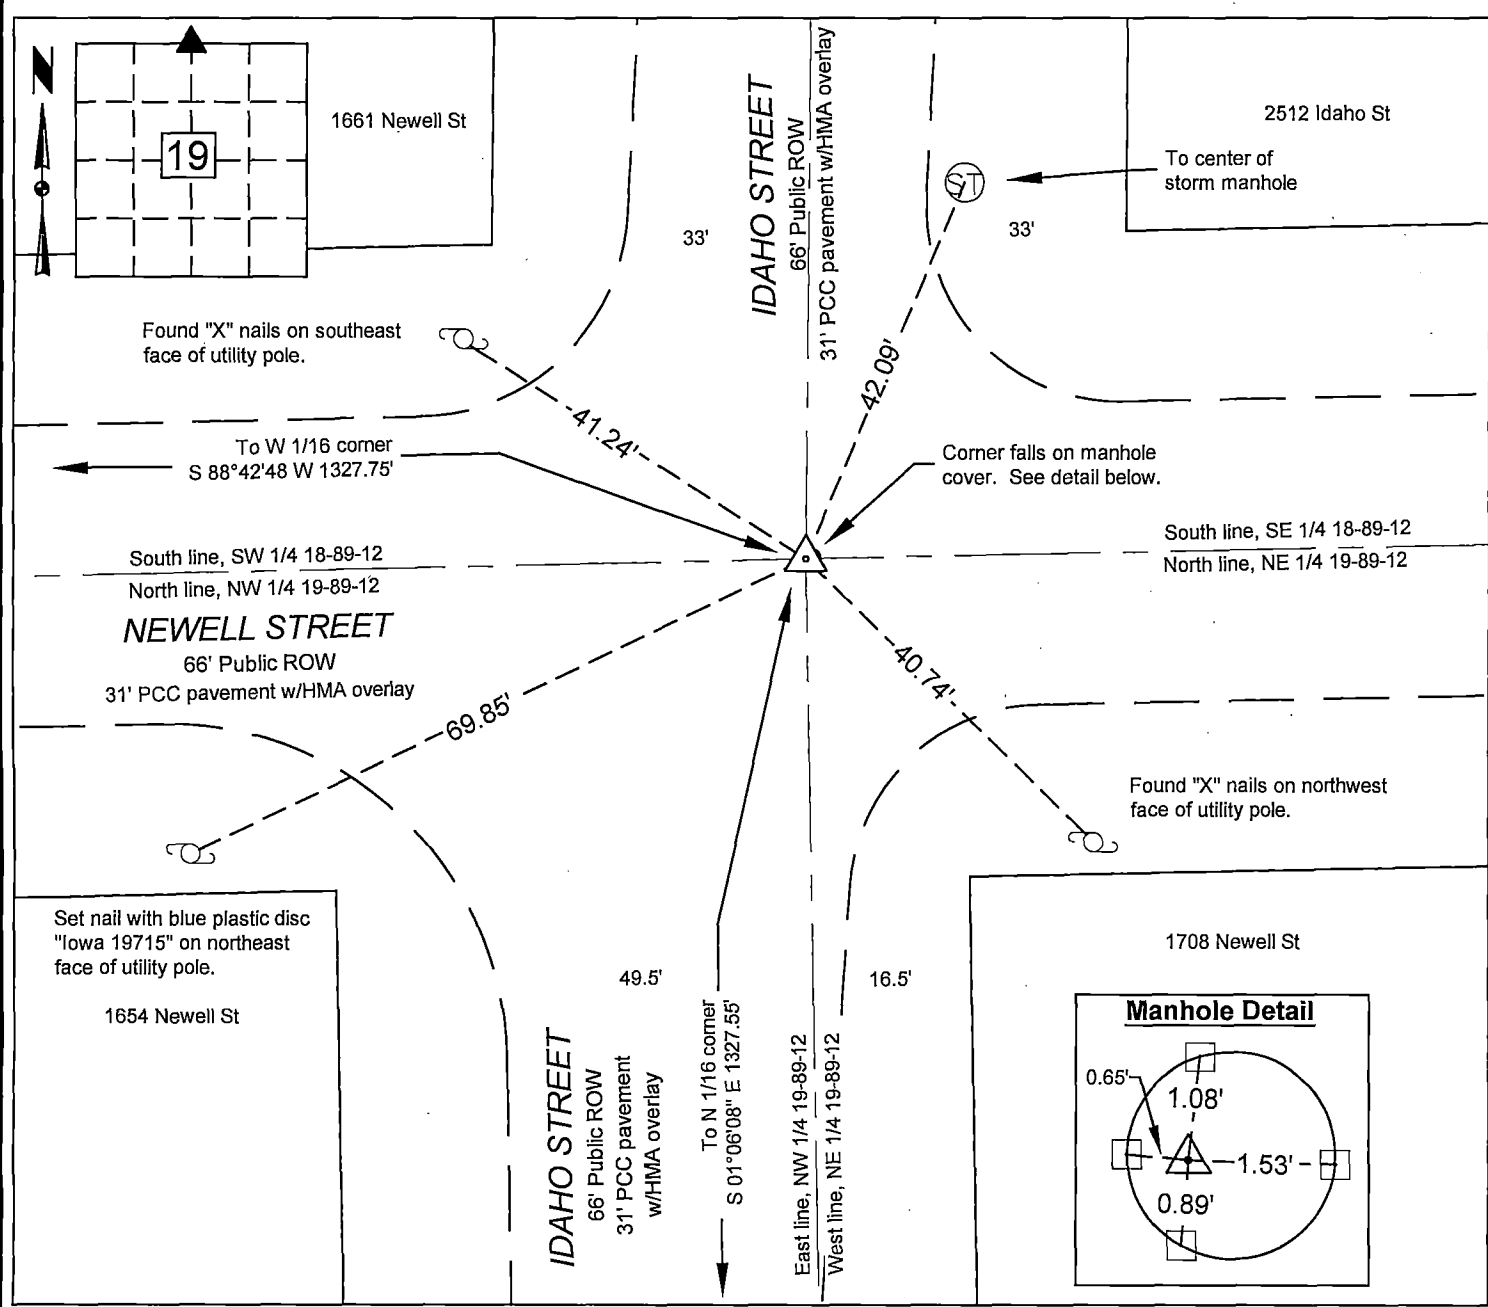

	I hereby certify that this surveying document was prepared and the related survey work was performed by me or under my direct personal supervision and that I am a duly licensed Land Surveyor under the laws of the State of Iowa. <i>William W. Castle</i> 12/12/2023 William W. Castle, PLS Date License Number 19715 My License Renewal Date is December 31, 2023. Pages or sheets covered by this seal : 1/1	List corners to be indexed			
	Corners	Section	Twp	Range	
	N 1/4	19	89	12	