

UNITED STATES PUBLIC LAND SURVEY CORNER CERTIFICATE

OF

Land Survey Monuments situated in Section 20, Township 89 N, Range 12 W, of the Fifth Principal Meridian, BLACK HAWK County, Iowa.
Previously recorded in Book _____, Page _____.



(Show reason for preparing this certificate, the evidence and detailed procedures used in establishing the corner positions and monumentation found or placed.)

Monument Description and Remarks: Section Corner was Re-established from
information found in Plat of Survey recorded in Book 260, Page 829
in the Black Hawk County Records office. Set P.K. Nail

PLAN - VIEW

(Show a minimum of three reference ties to durable physical objects, relevant monuments and physical conditions that will enable recovery of the corner.)

Survey Shiner in
Power Pole.
(RLS 5543)

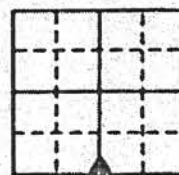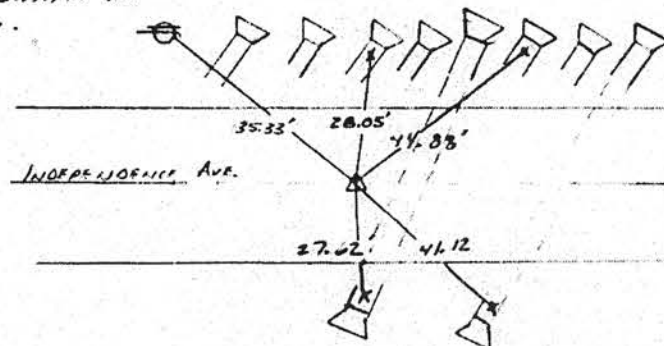

Found 'X's' cut
in top corner P.K.
@ 11/1/2001

I hereby certify that the survey work was completed and this certificate was prepared by me or under my direct personal supervision and that I am a duly registered land surveyor under the laws of the state of Iowa.

Dennis R. Prange 1/6/1992

REGISTERED LAND SURVEYOR NO. 10040

SEAL



List Corners to be Indexed

Corners	Section	Twp	Range
5/4 Cor.	20	89 N.	12 W.

BOOK **299** PAGE **395**