

PREPARED BY / RETURN TO: KENNETH D. STARK IOWA DEPARTMENT OF TRANSPORTATION 1420 4th ST. SE MASON CITY, IA 50401 641-423-7584

UNITED STATES PUBLIC LAND SURVEY CORNER CERTIFICATE  
OF

Land Survey Monuments situated in Section 26, Township 89N, Range 12W  
of the Fifth Principal Meridian, BLACK HAWK County, Iowa.

Previously recorded in Bk. 300, Pg. 473 - Bk. 300, - Pg. 475 in County Recorder's Office.  
(book, page, document number, etc.)


(Show reason for preparing this certificate, the evidence and detailed procedures used in establishing the corner positions and monumentation found or placed.)

Monument Description and Remarks: NW CORNER Replaced previously found Hinge nail with a Survey Mark Nail/IDOT Sec. Cor. washer #10898, 0.2' South of IA. 281 using previous cert of record Book 300, Page 473 after HMA resurfacing project. Reason for cert: Monumentation and ties have changed and updating IDOT records.

N<sup>1</sup>/<sub>4</sub> CORNER: Replaced previously found 3/4" Iron pin 0.6' deep with a Survey Mark Nail/ IDOT Sec. Cor. washer #10898 on IA. 281 using previous cert of record Book 300, Page 475 after HMA resurfacing project. Reason for cert: Monumentation and ties have changed and updating IDOT records.

PLAN - VIEW

(Show a minimum of three reference ties to durable physical objects, relevant monuments and physical conditions that will enable recovery of the corner.)

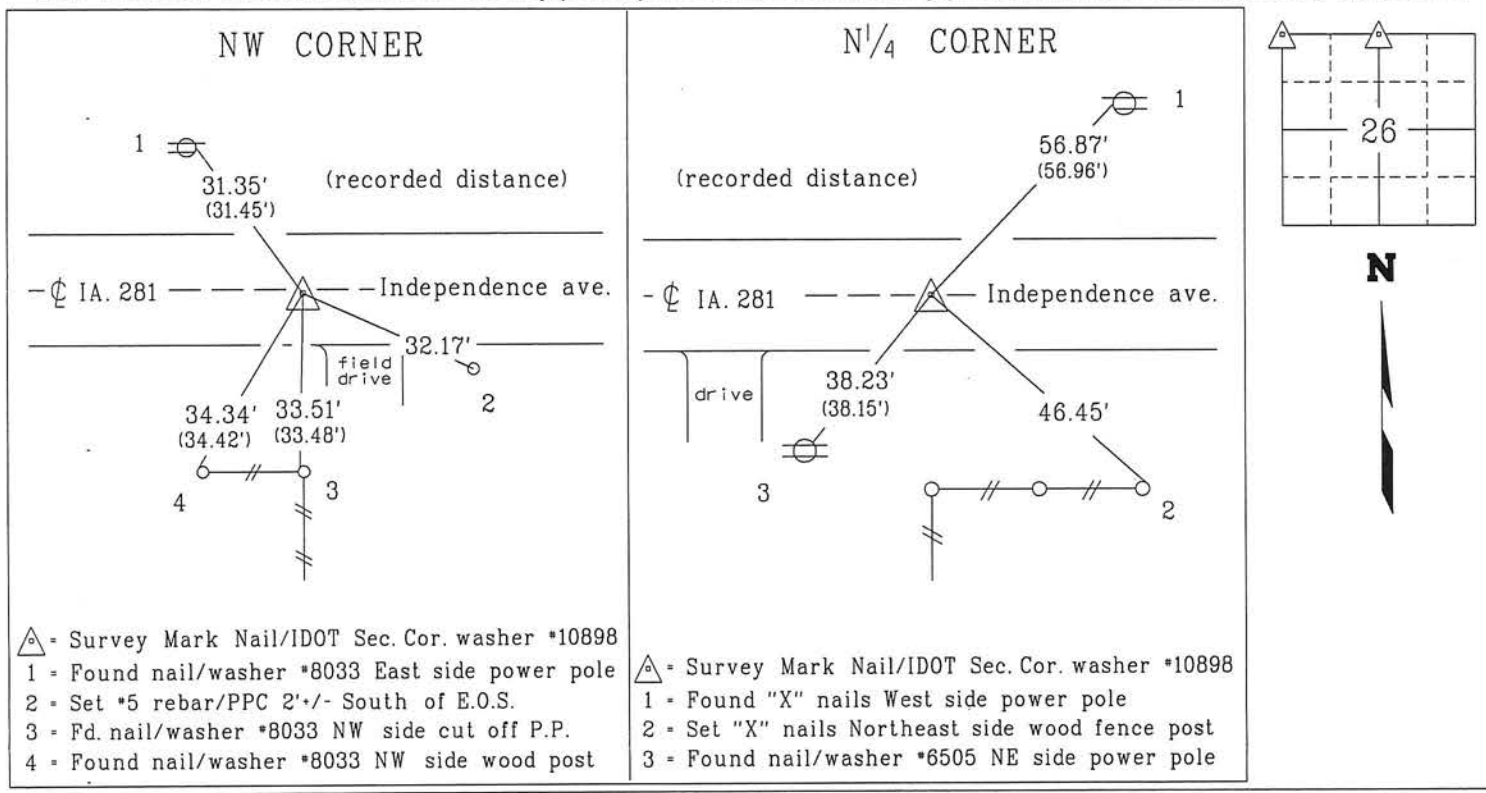

I hereby certify that this land surveying document was prepared and the related survey work was performed by me or under my personal supervision and that I am duly licensed Land Surveyor under the laws of the state of Iowa.


Kenneth D. Stark Date 05-15-15

Kenneth D. Stark

License number 10898

My license renewal date is December 31, 2015

Pages or sheets covered by this seal. 1

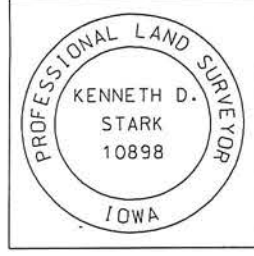

List Corners to be Indexed			
Corner	Section	Township	Range
NW CORNER	26	89N	12W
N <sup>1</sup> / <sub>4</sub> CORNER	26	89N	12W
PPC = Pink Plastic Cap (reference point) E.O.S. = Edge of slab P.P. = Power pole			
drawn by: cjs 3/13			