


Doc ID: 006802970001 Type: GEN Recorded: 07/02/2015 at 08:55:05 AM Fee Amt: \$7.00 Page 1 of 1 Black Hawk County Iowa SANDIE L. SMITH RECORDER

PREPARED BY / RETURN TO: KENNETH D. STARK IOWA DEPARTMENT OF TRANSPORTATION 1420 4th ST. SE MASON CITY, IA 50401 641-423-7584 UNITED STATES PUBLIC LAND SURVEY CORNER CERTIFICATE

OF

| Land Survey Monuments situated in Section 28, Township 89N, Ran   | ige 12W                 |
|---|-------------------------|
| of the Fifth Principal Meridian, BLACK HAWK County, Iowa.   |                         |
| Previously recorded inFILE 2011-00001028 in County Recorder's   | Office.                 |
| (Show reason for preparing this certificate, the evidence and detailed procedures used in establishing t and monumentation found or placed.)  | he corner positions     |
| Monument Description and Remarks:   |                         |
| N 1/4 COR = REPLACED PREVIOUSLY FOUND *5 REBAR WITH SURVEY MARK NAIL  |                         |
| SEC. COR WASHER ON € IA. 281 AFTER 2012 HMA OVERLAY PROJECT STP-281-1(45)20   | C-07 PER                |
| PREVIOUS CERT: FILE 2001-00001028. REASON FOR CERT: CHANGE TO MONUMENT  |                         |
|   |                         |
|   |                         |
|   |                         |
|   |                         |
| PLAN - VIEW  (Show a minimum of three reference ties to durable physical objects, relevant monuments and physical conditions that will enable | recovery of the corner) |
| 2000 00 00 00 00 00 00 00 00 00 00 00 00  | A                       |
| N 1/4 COR   |                         |
|   |                         |
| 1 2   | 28                      |
|   | ļ                       |
| 32.98′ 54.76′   |                         |
| (32.99') 5 10   | N                       |
|   | N.                      |
| -¢ IA. 281  |                         |
|   |                         |
|   | N                       |
| 33.00' 00',   |                         |
| 3   |                         |
| WHITE VINYL FENCE \$4   | 1                       |
| 1   |                         |
| · •   |                         |
| A = SURVEY MARK NAIL & IDOT 10898 WASHER  |                         |
| 1 = FOUND *4 REBAR/YELLOW PLASTIC CAP 8505  |                         |
| 2 - FOUND *4 REBAR NO CAP   |                         |
| 3 - FOUND NAIL/METAL WASHER NW SIDE POWER POLE 4 - FOUND MAG NAIL/WASHER EAST SIDE WOOD END POST  |                         |
| List Conners to b   | ev version from the     |

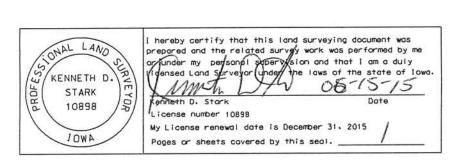

| List Corners to be Indexed |      |        |         |          |       |  |
|----------------------------|------|--------|---------|----------|-------|--|
| · (                        | Corn | er     | Section | Township | Range |  |
| N                          | 1/4  | CORNER | 28      | 89N      | 12W   |  |
|                            |      |        |         |          |       |  |
|                            |      |        |         |          |       |  |

TIED:ME/CS DRAWN:ME