INDEX BLACK HAWK COUNTY, IOWA:ss

FEE BOOK # 2003 30861

**PROOF** 

FILED FOR RECORD

2003 , AT 4:00P. M.


 $fee_{1-5.00/}$ 

COMPARED

BLACK HAWK COUNTY RECORDER

HELLAND ENGINEERING & SURVEYING LTD

## Paul H. Helland, 1107 Technology Parkway, Cedar Falls, Iowa 50613-6951, (319)-266-0161 UNITED STATES PUBLIC LAND SURVEY CORNER CERTIFICATE LAND SURVEY MONUMENTS SITUATED IN SECTION NO. 30 , TOWNSHIP NO. 89 \_\_WEST OF THE FIFTH PRINCIPAL MERIDIAN,\_\_\_\_\_BLACK HAWK COUNTY, IOWA. PREVIOUSLY RECORDED IN BOOK (SHOW REASON FOR PREPARING THIS CERTIFICATE, THE EVIDENCE AND DETAILED PROCEDURES USED IN ESTABLISHING THE CORNER POSITIONS AND MONUMENTATION FOUND OR PLACED.) MONUMENT DESCRIPTION AND REMARKS: NO CORNER CERTIFICATE ON FILE. SURVEY DONE IN NE 1/4 SE 1/4 OF SEC. 30-T89N-R12W. NW CORNER NE 1/4 SE 1/4: NO BLACK HAWK COUNTY ENGINNER REFERENCE TIES EXIST. FOUND NO. 4 REBAR W/YELLOW PLASTIC CAP (# ILLEGIBLE), BUT IT'S POSITION IS INCONSISTENT W/SEVERAL MONUMENTS IN AREA (i.e. PARCEL "C" & "E", PINCHED PIPE TO THE WEST AND NO. 4 REBAR W/YELLOW CAP #7034 ON SOUTH LINE OF NORTH 803.5' OF THE NE 1/4 SE 1/4). SET NO. 4 REBAR W/ORANGE PLASTIC CAP #6505, 50.0' EAST OF THE NE CORNER OF "SUNSHINE SUBDIVISION" (FOUND PINCHED PIPE) ON STRAIGHT LINE TOWARDS THE E 1/4 CORNER. CORNER AS ESTABLISHED IS 1.6' NORTH & 0.6' EAST OF SAID FOUND NO. 4 REBAR W/YELLOW PLASTIC CAP. PLAN VIEW (SHOW A MINIMUM OF THREE REFERENCE TIES TO DURABLE PHYSICAL OBJECTS, RELEVANT MONUMENTS AND PHYSICAL CONDITIONS THAT WILL ENABLE RECOVERY OF THE CORNER.) 100' FORMER RR R.O.W. FOUND STEEL TAG #5543 SE FACE UTILITY POLE 30 NW CORNER OF NE 1/4 SE 1/4 . O. SET ORANGE TAG SE FACE 1.5'± UP 4"Ø TREE DUE WEST **DUE EAST** 50.00' 1321.85 NE CORNER OF "SUNSHINE SUBDIVISION" FOUND PINCHED PIPE E 1/4 CORNER-SEC. 30-T89N-R12W SET ORANGE TAG SW FACE 2'± UP 8"Ø TREE FOUND NO. 4 REBAR PER 340 MISC. 645 \<u>&</u> S39°17'E 77,44' FOUND NO. 4 REBAR w/YELLOW CAP #9961 ·S40°35¾'E 136.84'

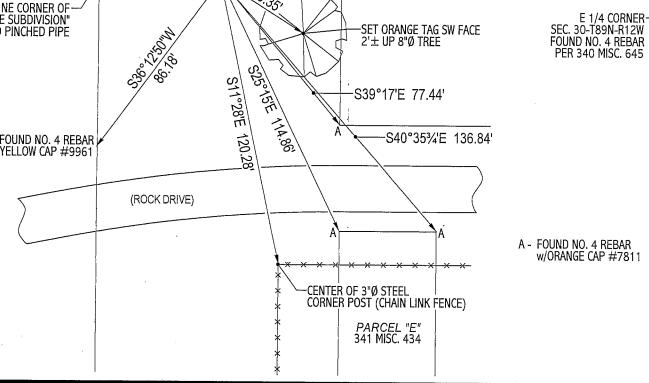

PAUL H. HELLAND

6505

/OWA

HELLAND ENGINEERING & SURVEYING, LTD. 1107 Technology Parkway

Cedar Falls, Iowa 50613-6951

(319)-266-0161

PROFESSION PA

I hereby certify that this land surveying document was prepared and the related survey work was performed by me or under my direct personal supervision and that I am a duly licensed Land Surveyor under the laws of the State of Iowa.

ad 4. Hellel Paul H. Helland

License Number 6505

My license renewal date is December 31, 2003 All pages or sheets are covered by this seal except: (00.00') - RECORDED AS

FILE NAME: 03-139CC.DRG

LIST CORNERS TO BE INDEXED SECTION TOWNSHIP RANGE

NW CORNER NE 1/4 SE 1/4 89N

12W