


DOC ID: 006745220001 To Recorded: 04/29/2015 at Fee Amt: \$7.00 Page 1 of Black Hawk County Iowa SANDIE L. SMITH RECORDER

File 2015-00017411

* Ret! VJ Engineering 1501 Technology Prixwy Suite 100, CF United States Public Land Survey Corner Certificate of Land Survey Monuments situated in Section No. _ ___, Township No. 34 Range No. 12 West, of the Fifth Principal Meridian, Black Hawk Previously recorded in 345 Misc. 527 Show reason for preparing this certificate, the evidence and detailed procedures used in establishing the corner positions and monumentation found or placed.) Monument Description and Remarks: South Quarter Corner Section 34 T89N R12W Corner Certificate 345 Misc. 527 calls out finding a 1/2"Ø rebar, searched area with metal locator and found 1/2"Ø rebar. Corner was used for a survey in the NE 1/4 SW 1/4 of Section 34 T89N R12W. This corner certificate is being prepared due to a change to the reference ties. PLAN - VIEW (Show a minimum of three reference ties to durable physical objects, relevant monuments and physical conditions that will enable recovery of the corner.) Fnd Orange Tag 34 SW Face Power Pole ·87.20, **LEGEND** Set Mag Nail in Wood Post of Road Closure Barricade Found Section Corner Set Section Corner Lafavette Road Set 5/8"Ø x 24" Rebar w/ 73.58 Orange Cap Iowa P.L.S. #22561 End of Paving 0



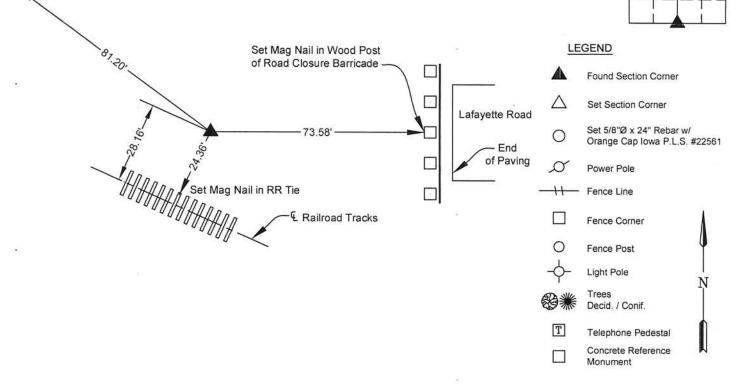

I hereby certify that this land surveying document was prepared and the related survey work was performed by me or under my direct personal supervision and that I am a duly licensed Land Surveyor under the laws of the State of Iowa

4-24-15

License Number 22561

Matthew A. Koffa, P.L.S.

My license renewal date is December 31, 2016 Pages or sheets covered by this seal:

List Corner to be Indexed

Corner Section

Twp

Range

South 1/4

Date

34

89 North

12 West

VJ Engineering 1501 Technology Parkway Cedar Falls, Iowa - 319-266-5829

Section Corner Reference Ties file no. 158013

drawn by date 4/24/1