

UNITED STATES PUBLIC LAND SURVEY CORNER CERTIFICATE

SLSI 9-90

OF


Land Survey Monuments situated in Section 12, Township 89N, Range 13W, of the Fifth Principal Meridian, BLACK HAWK County, Iowa. previously recorded in N/A (book, page, document number, etc.) in County Recorder's Office.

(Show reason for preparing this certificate, the evidence and detailed procedures used in establishing the corner positions and monumentation found or placed.)

Monument Description and Remarks: SANITARY MANHOLE FOUND AT THIS LOCATION. CORNER POSITION RE-ESTABLISHED FROM NORTH WATERLOO PLACE PLAT OF 1909. "X" WAS CUT IN S.E. RIM OF MANHOLE RING.

PLAN - VIEW


(Show a minimum of three reference ties to durable physical objects, relevant monuments and physical conditions that will enable recovery of the corner.)

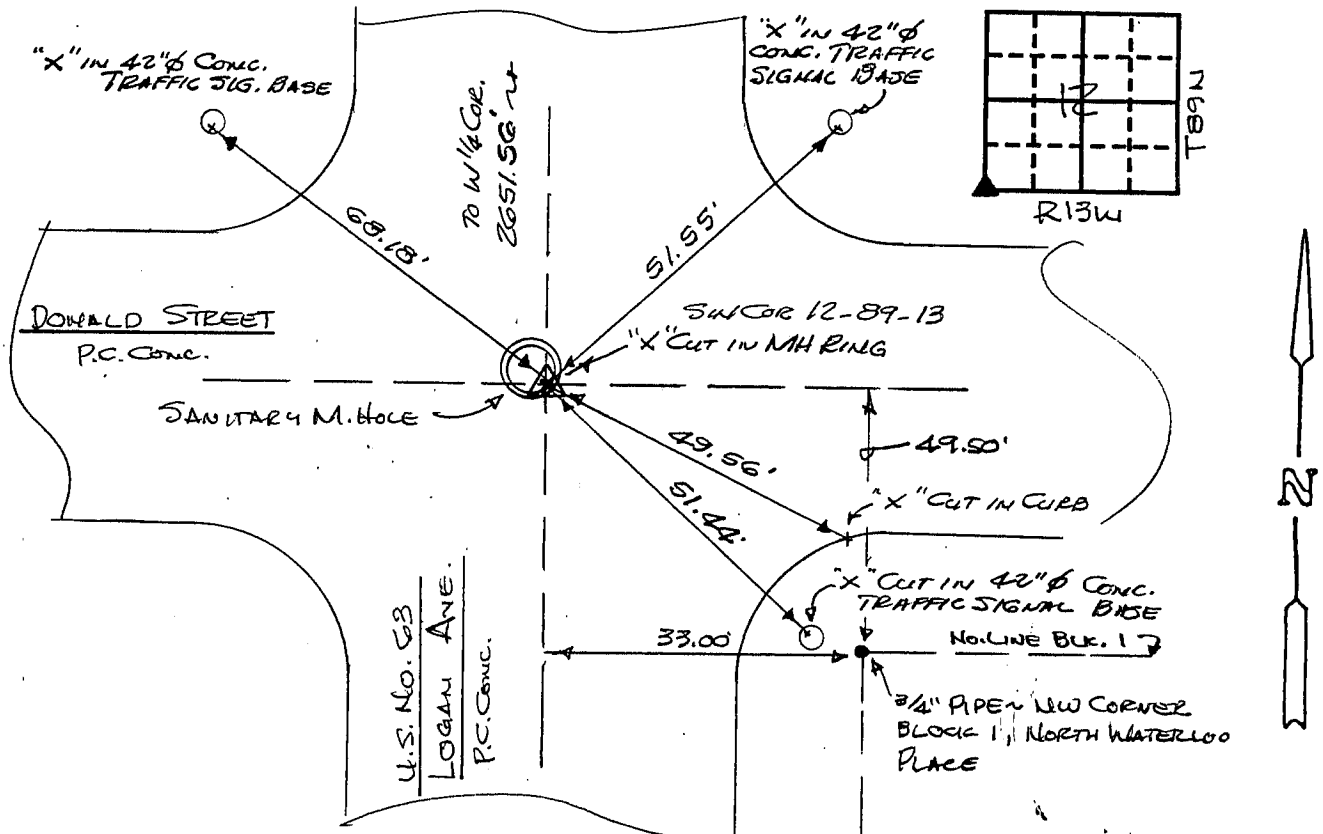

I hereby certify that the survey work was completed and this certificate was prepared by me or under my direct personal supervision and that I am a duly registered land surveyor under the laws of the state of Iowa.

Signature: F. William King
Name typed or printed: F. WILLIAM KING
Date: 6-14-1991 Reg. No. 8033

Corners	List Corners to be Indexed	Section	Twp	Range
SW	12	89N	13W	

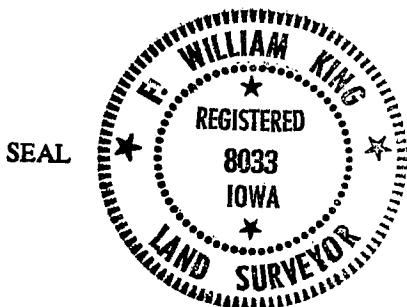

MISC. BK. 296 p. 441