

SC/ Misc/ INDEX MARGIN PROOF or COMPARE

BLACK HAWK COUNTY IOWA: 88
Filed for record Mar 1, 19 96 at
2:00 P.M. and recorded in Book 319
of Misc. Page 744
William King Recorder
Fee 1-5.00/

15612

County Assessor

WAYNE CLAASSEN ENGINEERING AND SURVEYING, INC.
P.O. BOX 898 WATERLOO, IOWA 50704-0898

PHONE: (VOICE) 319-235-6294
(FAX) 319-235-0028

UNITED STATES PUBLIC LAND SURVEY CORNER CERTIFICATE


Land Survey Monuments situated in Section 19, Township 89N, Range 13W, of the Fifth Principal Meridian, BLACK HAWK County, Iowa.
Previously recorded in Misc. 305-272 (2-26-92) in County Recorder's Office.
(book, page, document number, etc.)

(Show reason for preparing this certificate, the evidence and detailed procedures used in establishing the corner positions and monumentation, found or placed.)

Monument Description and Remarks FOUND BROKEN MONUMENT AT 18" BELOW
GROUND. ALL PREVIOUS TIE TREES GONE. SURVEY MARKER STON WAS STILL
INTACT AT 0.8' N. OF MONUMENT. SET 1/2" REBAR & CAP 8033 OVER MONUMENT
FLUSH WITH SURFACE. POWER POLE @ 34.42' S.E. WAS ONLY REMAINING TIE.


PLAN - VIEW

(Show a minimum of three reference ties to durable physical objects, relevant monuments and physical conditions that will enable recovery of the corner.)

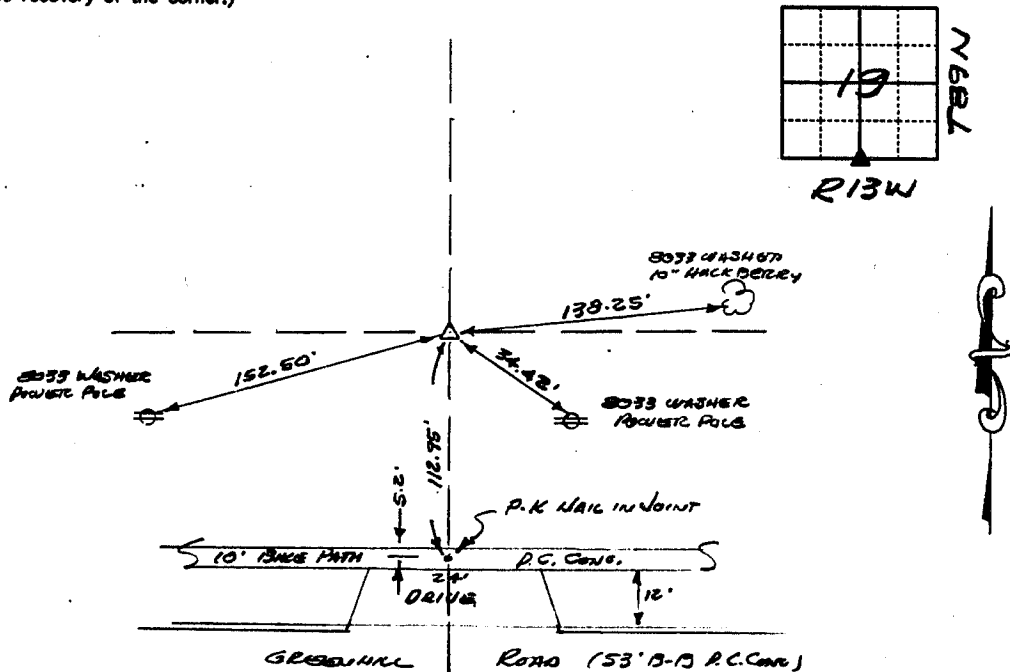

I hereby certify that the survey work was completed and this certificate was prepared by me or under my direct personal supervision and that I am a duly registered land surveyor under the laws of the state of Iowa.

Signature: *F. William King*
(Name typed or printed) *F. William King*
Date: *Mar 1, 1996* Reg. No. *8033*

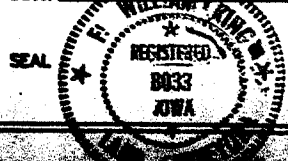

List Corners to be Indexed

Corners	Section	Twp	Range
5/4	19	89N	13W

BOOK 319 PAGE 744