

Index Legend	
County:	Black Hawk
Section(s):	29 Township: 89 N Range: 13 W
Corner(s):	East 1/4 Corner
Requestor:	City of Waterloo
Proprietor:	City of Waterloo
Surveyor:	William W. Castle
Surveyor Company:	City of Waterloo Engineering Department 715 Mulberry Street, Waterloo, IA 50703
Return To:	715 Mulberry St, Waterloo, IA 50703 291-4312



Doc ID: 011869040001 Type: GEN  
Recorded: 11/21/2022 at 03:08:54 PM  
Fee Amt: \$7.00 Page 1 of 1  
Black Hawk County Iowa  
SANDIE L. SMITH RECORDER  
File **2023-00008115**


United States Public Land Survey Corner Certificate

Land Survey Monument situated in Section 29, Township 89 North, Range 13 West, of the Fifth Principal Meridian, Black Hawk County, Iowa.  
Previously recorded in Doc. # 2003 6766 and Misc. Book 337 Page 811 in the Black Hawk County Recorder's Office.

Reason for preparing this certificate, the evidence and detailed procedures used in establishing the corner position, and monumentation found or placed.  
Intersection reconstructed as part of the City of Waterloo's FY2021 Street Reconstruction Program, Contract No. 1024. Prior to construction, found 3" aluminum disc in concrete sanitary manhole boxout. Disc and reference monuments placed on December 14, 1987, by Brice, Petrides, Donohue as part of the FY1987 Hackett Road By-Pass, Iowa DOT Project IX-6585(7)--79-07, City Contract No. 340. Ties for this work were not recorded but obtained from AECOM in preparation for this work. After construction, placed a cut "X" in the west side of the sanitary manhole boxout at corner using project controls.

PLAN VIEW

Show a minimum of three reference ties to durable physical objects, relevant monuments and physical conditions that will enable recovery of the corner.

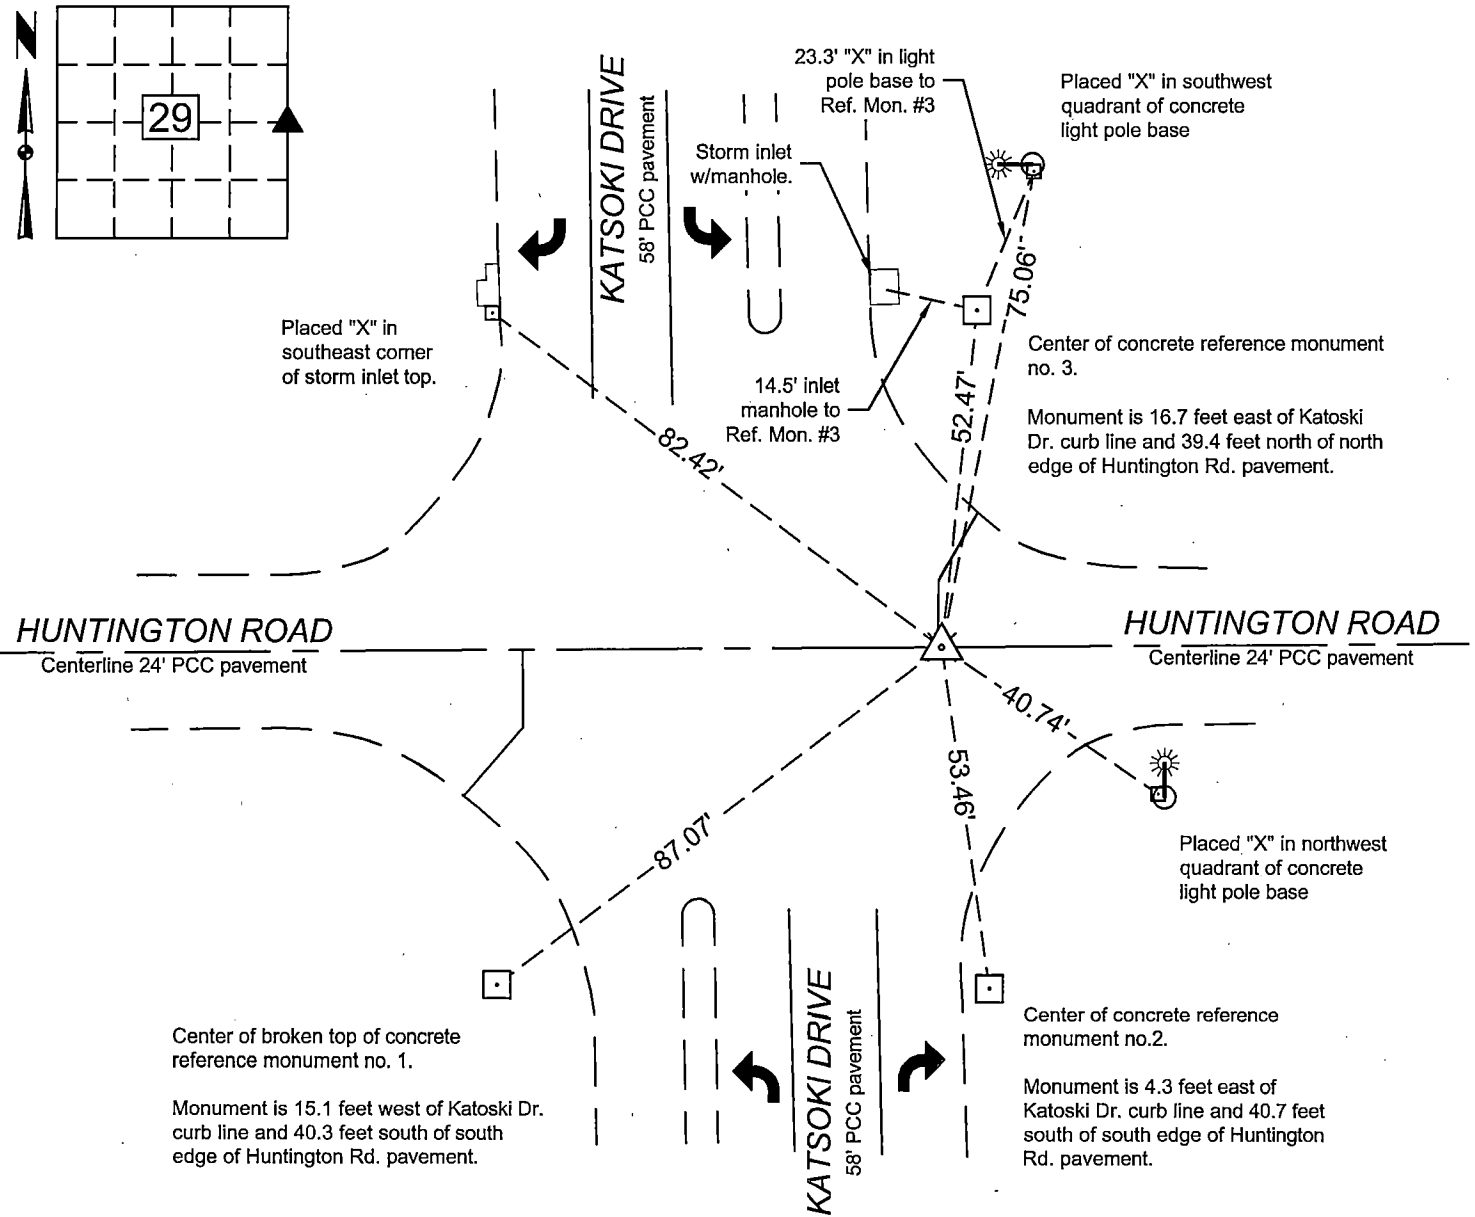

I hereby certify that this surveying document was prepared and the related survey work was performed by me or under my direct personal supervision and that I am a duly licensed Land Surveyor under the laws of the State of Iowa.  
*William W. Castle* 11/1/2022  
William W. Castle, PLS Date  
License Number 19715  
My License Renewal Date is December 31, 2023. 1/1  
Pages or sheets covered by this seal :

List corners to be indexed			
Corners	Section	Twp	Range
E 1/4	29	89	13

City of Waterloo Engineering Department  
715 Mulberry Street, Waterloo, Iowa 50703  
Phone: (319) 291-4312 Fax: (319) 291-4262

Drawn By: WWC Scale: 1" = 30'  
Field Work Date: 7-1-2022  
Date Drawn: 11-1-2022

Sheet No.  
**1 of 1**