

UNITED STATES PUBLIC LAND SURVEY CORNER CERTIFICATE OF

Land Survey Monuments situated in Section 7, Township 90 N, Range 12 W
of the Fifth Principal Meridian, BLACK HAWK County, Iowa. Previously recorded
in _____ in County Recorder's Office.

(book, page, document number, etc.)

(Show reason for preparing this certificate, the evidence and detailed procedures used in establishing the corner positions and monumentation found or placed.)

Monument Description and Remarks

A - FOUND NAIL OVER MONUMENT


B - FOUND 5/8" REBAR

C - 6x6 WOOD CORNER POST

D - POWER POLE

PLAN VIEW

(Show a minimum of three reference ties to durable physical objects, relevant monuments and physical conditions that will enable recovery of the corner.)

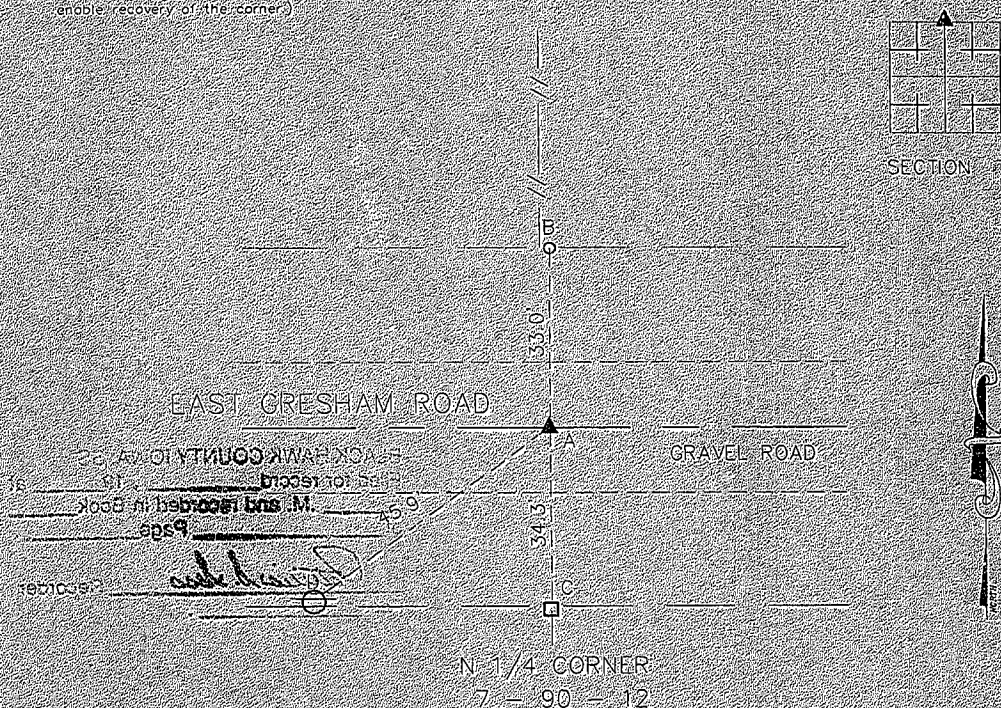

I hereby certify that this land surveying document was prepared by me or under my direct personal supervision and that I am a duly Registered Land Surveyor under the laws of the State of Iowa.

Signature: Terry D. Van Lanning
Terry D. Van Lanning, PLS.

Date: Feb 26, 1996 Reg. No. 10793

My registration renewal date is December 31, 1997.

SEAL



List Corners to be Indexed

Corners	Section	Township	Range
N 1/4 COR.	07	90 N	12 W

BOOK 319 PAGE 707

TERRY D. VAN LANNINGHAM, PLS., INC.
210 15TH AVE. NW WAVERLY, IOWA (515) 352-2132