

UNITED STATES PUBLIC LAND SURVEY CORNER CERTIFICATE OF

and Survey Monuments situated in Section 20 Township 90 N Range 12 W
the Fifth Principal Meridian BLACK HAWK County, Iowa. Previously recorded
in County Recorder's Office.


(book, page, document number, etc.)
Now reason for preparing this certificate, the evidence and detailed procedures used in establishing the corner positions and
documentation found or placed.)

Monument Description and Remarks:

- 1 - FOUND CONC MONUMENT BROKEN ON TOP - PLACE RR SPK OVER CENTER
- 2 - SET NAIL IN FENCE CORNER POST
- 3 - SET NAIL IN POWER POLE
- 4 - SET NAIL IN FENCE GATE CORNER POST

PLAN VIEW

Show a minimum of three reference ties to durable physical objects, relevant monuments and physical conditions that will
enable recovery of the corner.)

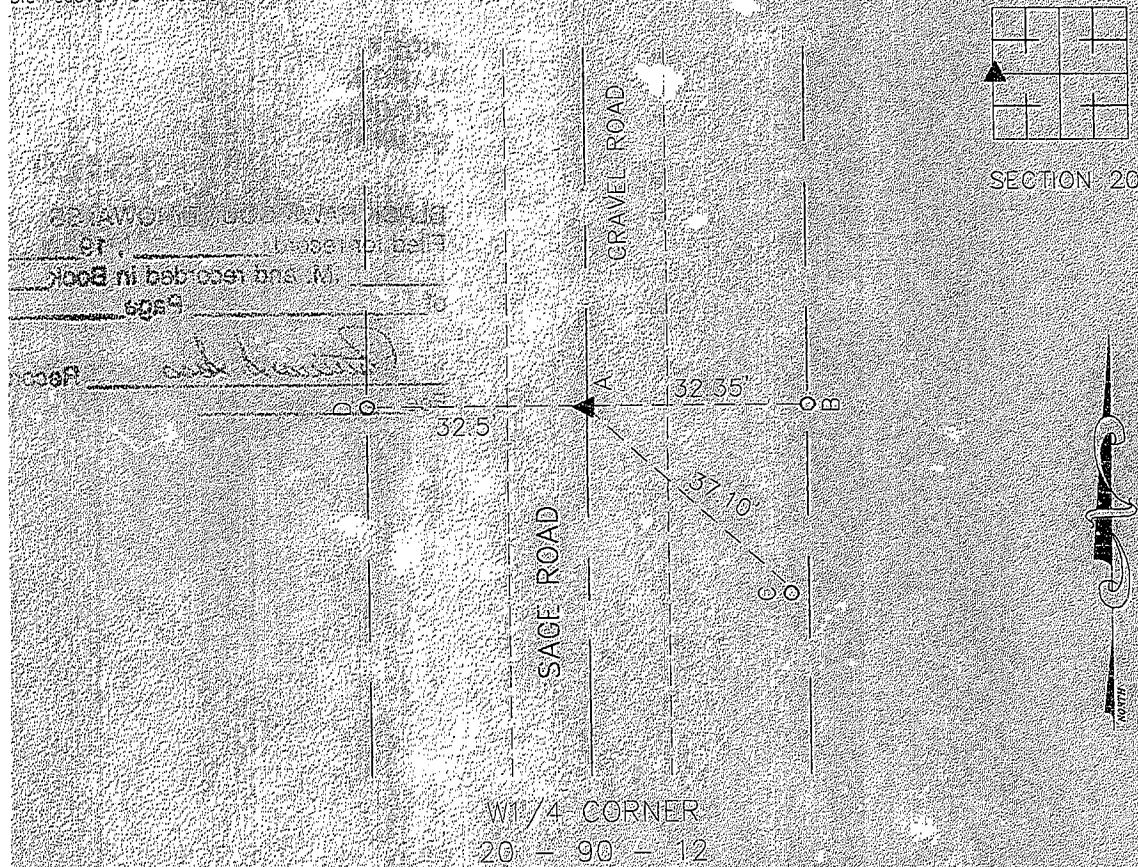

I hereby certify that this land surveying document was prepared by
under my direct personal supervision and that I am a duly
licensed Land Surveyor under the laws of the State of Iowa.

Signature: Terry D. Van Lanningham
Terry D. Van Lanningham - PLS

Date: Feb 26, 1996 Reg No. 10793

Registration renewal date is December 31, 1997

List Corners to be Indexed

Corners	Section	Township	Range
W1/4 COR	20	90N	12 W



BOOK 319 PAGE 715