HELLAND ENGINEERING

Document Number: 2008007325

Date: Oct 02, 2007 4:30:00 pm

Aud Fee: 0.00

Rec Fee:

Rec Management Fee:

Trans Tax: 0.00

1.00


Non-Standard Page Fee:

1.00 0.00

 \mathbf{Z}

Filed for record in Black Hawk County, Iowa Judith A. McCarthy, County Recorder

Paul H. Helland, 1107 Technology Parkway, Cedar Falls, Iowa 50613-6951, (319)-266-0161 UNITED STATES PUBLIC LAND SURVEY CORNER CERTIFICATE LAND SURVEY MONUMENTS SITUATED IN SECTION NO._ 9 _, TOWNSHIP NO._ 90 NORTH, RANGE _WEST OF THE FIFTH PRINCIPAL MERIDIAN,_ **BLACK HAWK** COUNTY, IOWA. PREVIOUSLY RECORDED IN 316 MISC, 675 (SHOW REASON FOR PREPARING THIS CERTIFICATE, THE EVIDENCE AND DETAILED PROCEDURES USED IN ESTABLISHING THE CORNER POSITIONS AND MONUMENTATION FOUND OR PLACED.) MONUMENT DESCRIPTION AND REMARKS: USPLSCC REFERENCE TIES HAVE CHANGED. SURVEY COMPLETED IN THE NE 1/4 OF SEC. 9-T90N-R14W. N 1/4 CORNER: NO BLACK HAWK COUNTY ENGINEER REFERENCE TIES AVAILABLE. USPLSCC 316 MISC. 675 DATED 6/21/95 CALLS FOR [FOUND 1" REBAR ON CL ASPHALT PAVING]. FOUND NO. 6 REBAR CORRESPONDING WITHIN REASON TO SINGLE REMAINING TIE. ALSO CORRESPONDS WITHING REASON TO DISTANCE FROM THE NE CORNER PER GEOFF TINKER, L.S., IN THE OFFICE OF THE BLACK HAWK COUNTY ENGINEER. PLAN VIEW (SHOW A MINIMUM OF THREE REFERENCE TIES TO DURABLE PHYSICAL OBJECTS, RELEVANT MONUMENTS AND PHYSICAL CONDITIONS THAT WILL ENABLE RECOVERY OF THE CORNER.) FOUND "X" NAILS S FACE UTILITY POLE (NOT TO SCALE) (FIELD ENTRANCE) N 1/4 CORNER . 9 WINSLOW ROAD (A.C.C. PAVEMENT)

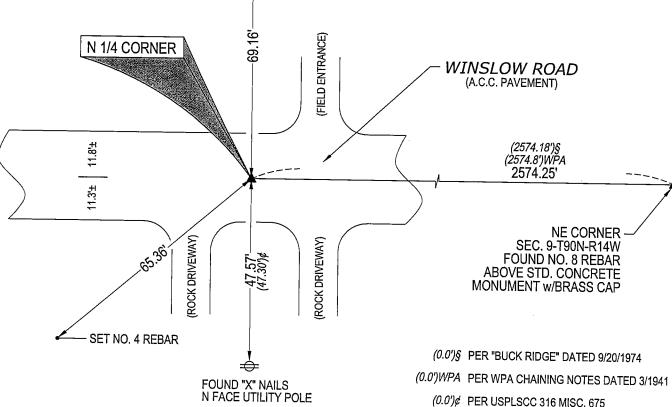



HÉLLAND 6505

AWO\

HELLAND ENGINEERING & SURVEYING, LTD.

1107 Technology Parkway Cedar Falls, Iowa 50613-6951 (319)-266-0161

I hereby certify that this land surveying document was prepared and the related survey work was performed by me or under my direct personal supervision and that I am a duly licensed Land Surveyor under the laws of the State of Iowa.

Paul H. Helland License Nimi Husel

Paul n. nellanu License Number 6505 My license renewal date is December 31, 2007. All pages or sheets are covered by this seal except:

SHINER = 8D NAIL & 1 5/16"Ø METAL SHINER BRASS TAG = 13/16"Ø BRASS TAG OPC = PLASTIC CAP (O=ORANGE, R=RED, Y=YELLOW) (00") RECORDED AS FILE NAME: 07-204C1.DWG

LIST CORNERS TO BE INDEXED SECTION TOWNSHIP

