

Doc ID: 006860890001 T Recorded: 09/14/2015 at Fee Amt: \$7.00 Page 1 of Black Hawk County Iowa SANDIE L. SMITH RECORDER


File 2016-00005056


PREPARED BY / RETURN TO: KENNETH D. STARK IOWA DEPARTMENT OF TRANSPORTATION 1420 4th ST. SE MASON CITY, IA 50401 641-423-7584 UNITED STATES PUBLIC LAND SURVEY CORNER CERTIFICATE

OF

PLAN - VIEW

(Show a minimum of three reference ties to durable physical objects, relevant monuments and physical conditions that will enable recovery of the corner.)

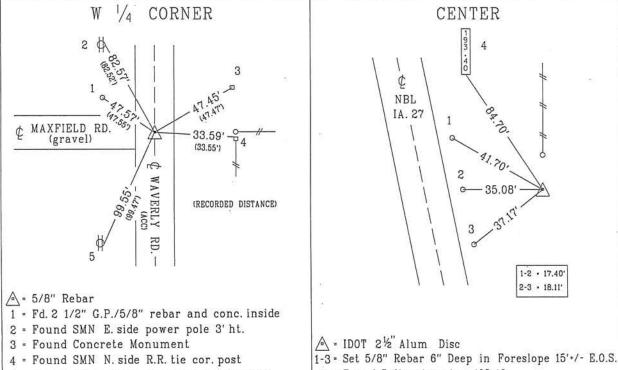

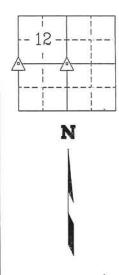

- 4 = Found SMN N. side R.R. tie cor. post
- 5 Found PK nail S.E. side power pole 2' ht.

4 = Found Delineater sign 193.40

07-12-90-14

KENNETH D. SERVEYO	I hereby certify that this prepared and the related sur- or under my personal supervi- licensed Land/Surveyor under	vey work was preformed by me
(교 10898 /육/	Kenneth D. Stark	Date
	License number 10898	
1000	My License renewal date is D	ecember 31, 2015 /
AWOI	Pages or sheets covered by the	nis seal.

List Corners to be Indexed						
Corner		ner	Section	Township	Range	
	W	1/4	CORNER	12	. 90N	14 W
			CENTER	12	90N	14 W