Hecorded: 02/20/2009 at 11:0 Fee Amt: \$7.00 Page 1 of 1 Instr# 200800017752 Black Hawk County Iowa JUDITH A MCCARTHY RECORDER Book 1080 Page 16693 - 16693


File 2009-00015413

## UNITED STATES PUBLIC LAND SURVEY CORNER CERTIFICATE

., Township .... 90 N \_, Range Land Survey Monuments situated in Section Black Hawk \_\_ County, Iowa \_\_\_\_\_, of the Fifth Principal Meridian, 14 W N/A \_\_\_\_, Page \_ Previously recorded in Book -Show reason for preparing this certificate, the evidence and detailed procedures used in establishing the corner positions and monumentation found or placed.) Monument Description and Remarks: Corner was used for a survey in the W 1/2 of the SW 1/4 of 33-90-14. Found Standard Concrete Monument w/ Brass Cap per W.P.A. monument ties dated 4-17-1941. There is a steel fence post on the East side of monument. No Corner Certificate Previously Recorded

## PLAN - VIEW

(Show a minimum of three reference ties to durable physical objects, relevant monuments and physical conditions recovery of the corner.)

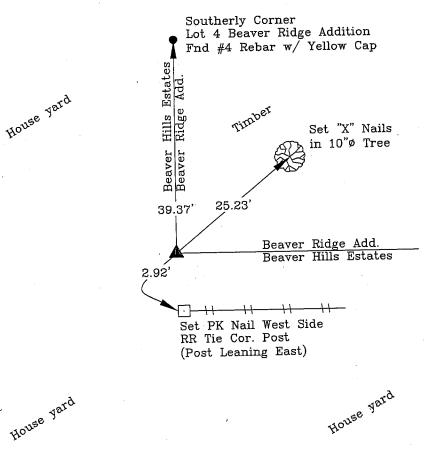

3 3

SECTION CORNER

LEGEND

 $\Box$ 

 $\Delta$ <del>-</del>-POWER POLE FENCE LINE FENCE CORNER

FENCE POST  $\odot$ LIGHT POLE

FOUND

TREE 

TELEPHONE PED.  ${f T}$ 

CONC. REF. MONUMENT

I hereby certify that this land surveying document was prepared and the related survey work was performed by me or under my direct personal supervision and that I am a duly licensed Land Surveyor under the laws of the State of lowa.



J. LUPKES, L.S. WENDELL

License number 12088 My license renewal date is December 31, 2010 List Corner to be Indexed

Section Corner West 1/4

Twp 90 N Range 14 W .

Pages or sheets covered by this seal:

VJ Engineering 1501 Technology Parkway Cedar Falls, Iowa - 319-266-5829 SECTION CORNER REFERENCE TIES

scale drawn by date