

Refiled to correct corner certificate previously recorded in section 34. Section should have been 24.

BY TERRY D. VAN LANINGHAM, PLS * 810 12TH AVENUE N.W. WAVERLY IOWA * (319)352-2132
UNITED STATES PUBLIC LAND SURVEY CORNER CERTIFICATE
OF

Land Survey Monuments situated in Section 24, Township 90 N, Range 15 W,
of the Fifth Principal Meridian, BUTLER County, Iowa. Previously recorded
in _____ in County Recorder's Office.

(book, page, document number, etc.)

(Show reason for preparing this certificate, the evidence and detailed procedures used in establishing the corner positions and monumentation found or placed.)


Monument Description and Remarks: _____

A - FOUND REBAR


B - 2" PIPE

PLAN VIEW

(Show a minimum of three reference ties to durable physical objects, relevant monuments and physical conditions that will enable recovery of the corner.)

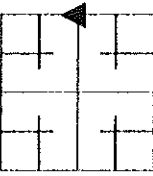

SECTION 24

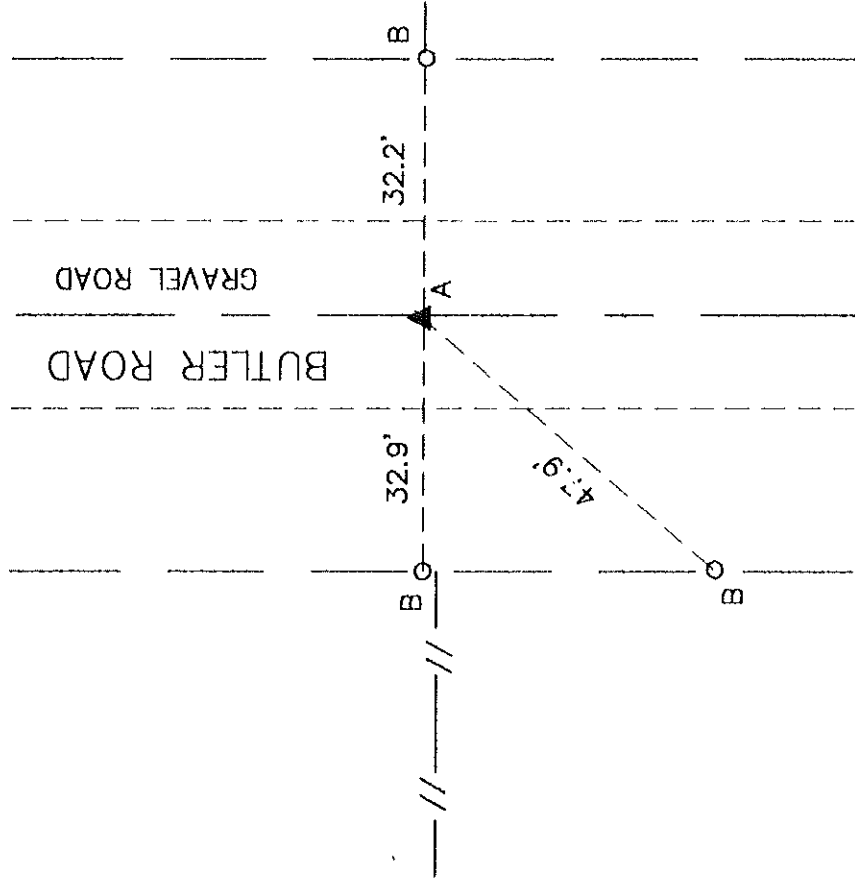


E 1/4 CORNER
24 - 90 - 15

I hereby certify that this land surveying document was prepared by me or under my direct personal supervision and that I am a duly Registered Land Surveyor under the laws of the State of Iowa.

Signature: Terry D. Van Laningham
Date: June 26, 1996 Reg. No. 10793

My registration renewal date is December 31, 1997.

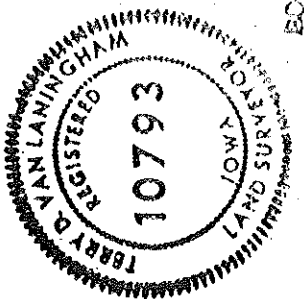

SEAL

List Corners to be Indexed

Corners	Section	Township	Range
E 1/4 COR.	24	90 N	15 W

STATE OF IOWA BUTLER COUNTY
FILED FOR RECORD THE 28 DAY OF
June 1996 AT 5:00 O'CLOCK
P.M. 10793 PAGE 157
FILED 10793 FEE 10.00
Terry D. Van Laningham RECORDER

BOOK 1 PAGE 137

TERRY D. VAN LANINGHAM, PLS. INC.
810 12TH AVE. NW WAVERLY, IOWA
(319) 352 - 2132

refiled to correct corner certificate previously recorded in section 34. Section should have been 24.

BY TERRY D. VAN LANINGHAM, PLS * 810 12TH AVENUE, NW, WAVERLY, IOWA * (319) 352-2132

UNITED STATES PUBLIC LAND SURVEY CORNER CERTIFICATE OF

2nd Survey Monuments situated in Section 24, Township 90 N, Range 15 W,
of the Fifth Principal Meridian, BUTLER County, Iowa. Previously recorded
in _____ in County Recorder's Office.

(book, page, document number, etc.)


(Show reason for preparing this certificate, the evidence and detailed procedures used in establishing the corner positions and monumentation found or placed.)

Monument Description and Remarks:

Summary of Section 24

PLAN VIEW

(Show a minimum of three reference ties to durable physical objects, relevant monuments and physical conditions that will enable recovery of the corner.)

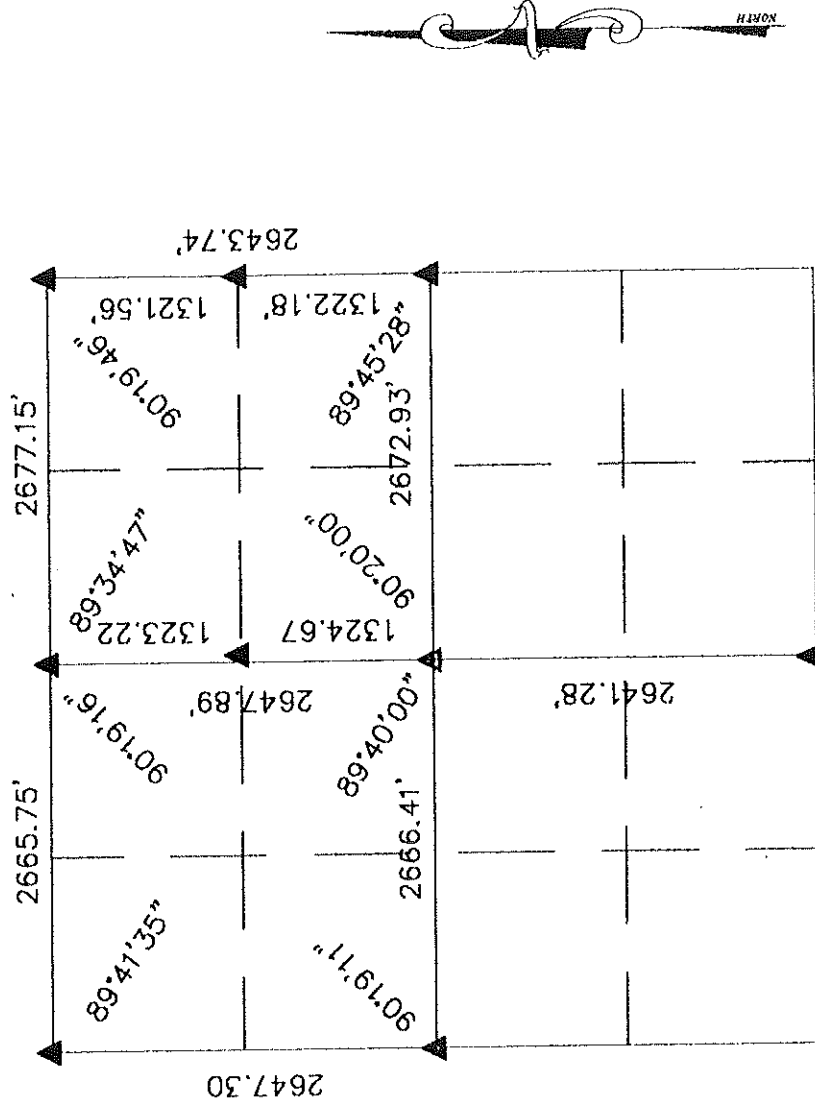

SECTION 24

I hereby certify that this land surveying document was prepared by
me or under my direct personal supervision and that I am a duly
Registered Land Surveyor under the laws of the State of Iowa.

Signature: Terry D. Van Laningham
Terry D. Van Laningham, PLS

Date: June 24, 1996 Reg. No. 10793

My registration renewal expires on December 31, 1997.



SEAL

List Corners to be Indexed

Corners Section Township Range

24 90 N 15 W

STATE OF IOWA BUTLER COUNTY
FILED FOR RECORD THE 28 DAY OF
JULY 1996 AT Y O'CLOCK
IN BOOK 1 PAGE 136
FILE NO. 1694 FEE 8.00
RECORDED

TERRY D. VAN LANINGHAM, PLS. INC.
810 12TH AVE. NW WAVERLY, IOWA (319) 352-2132

Refiled to correct corner certificate previously recorded in section 34. Section should have been 24.

BY TERRY D. VAN LANINGHAM, PLS * 810 12TH AVENUE N.W. WAVERLY IDWA * (319)352-2132
UNITED STATES PUBLIC LAND SURVEY CORNER CERTIFICATE
OF

Land Survey Monuments situated in Section 24, Township 90 N, Range 15 W,
of the Fifth Principal Meridian, BUTLER County, Iowa. Previously recorded
in _____ in County Recorder's Office.

(book, page, document number, etc.)

(Show reason for preparing this certificate, the evidence and detailed procedures used in establishing the corner positions and
monumentation found or placed.)

Monument Description and Remarks: _____

A - T-BAR - B. HANSEN


B - NAIL IN FENCE CORNER POST

C - NAIL IN POWER POLE

D - 2" PIPE

PLAN VIEW

(Show a minimum of three reference ties to durable physical objects, relevant monuments and physical conditions that will
enable recovery of the corner.)

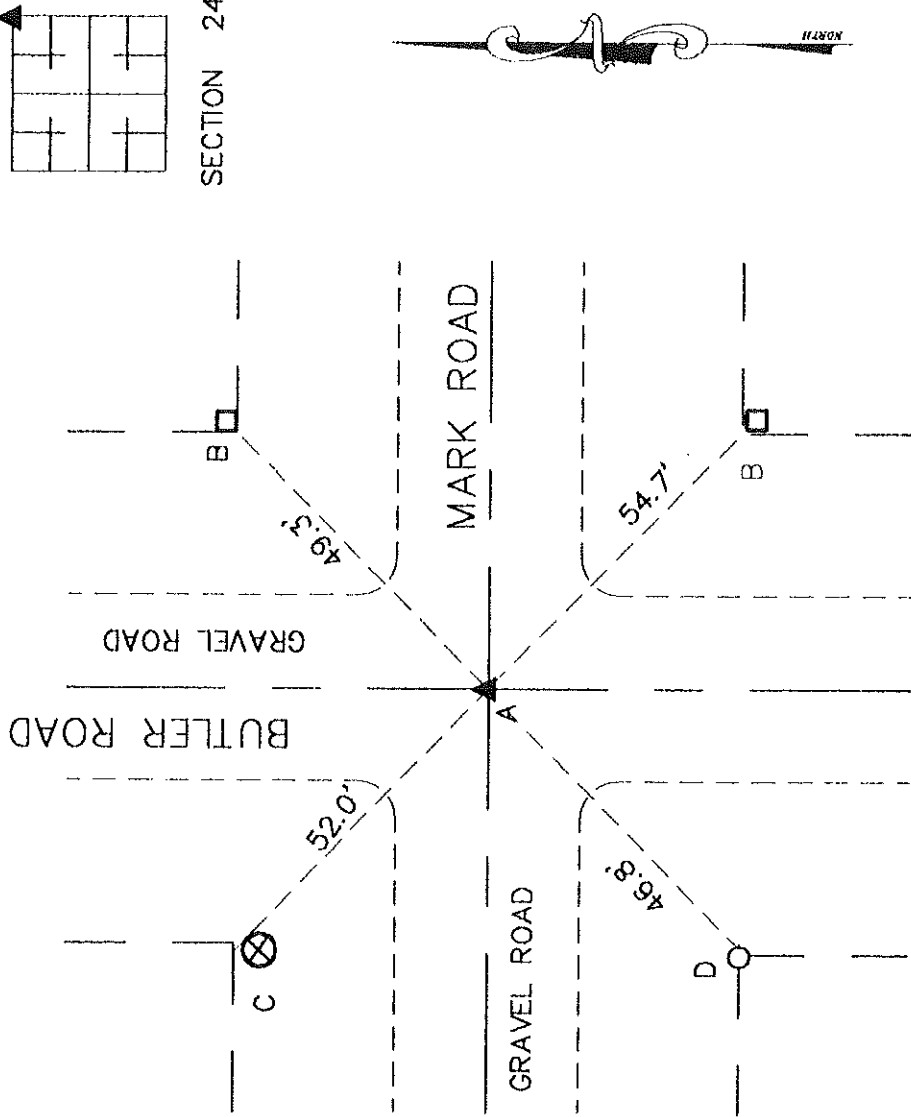


NE CORNER
24 - 90 - 15

I hereby certify that this land surveying document was prepared by
me or under my direct personal supervision and that I am a duly
Registered Land Surveyor under the laws of the State of Iowa.

Signature: Terry D. Van Laningham
Terry D. Van Laningham, PLS

Date: June 26, 1996 Reg. No. 10793

My registration renewal date is December 31, 1997.

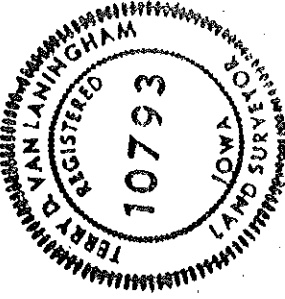

SEAL

List Corners to be Indexed

Corners	Section	Township	Range
NE COR	24	90 N	15 W

STATE OF IOWA BUTLER COUNTY
FILED FOR RECORD THE 28 DAY OF
June 1996 AT 1:50 O'CLOCK
JANECOS PAGE 140
FILE NO. 10793 REC. 10793
20.00 RECORDER

1996

BOOK 10793 PAGE 47

TERRY D. VAN LANINGHAM, PLS. INC.
810 12TH AVE. NW WAVERLY, IOWA (319) 352 - 2132