



UNITED STATES PUBLIC LAND SURVEY CORNER CERTIFICATE  
BLACK HAWK COUNTY, IOWA  
SECTION 2-T87N-R11W

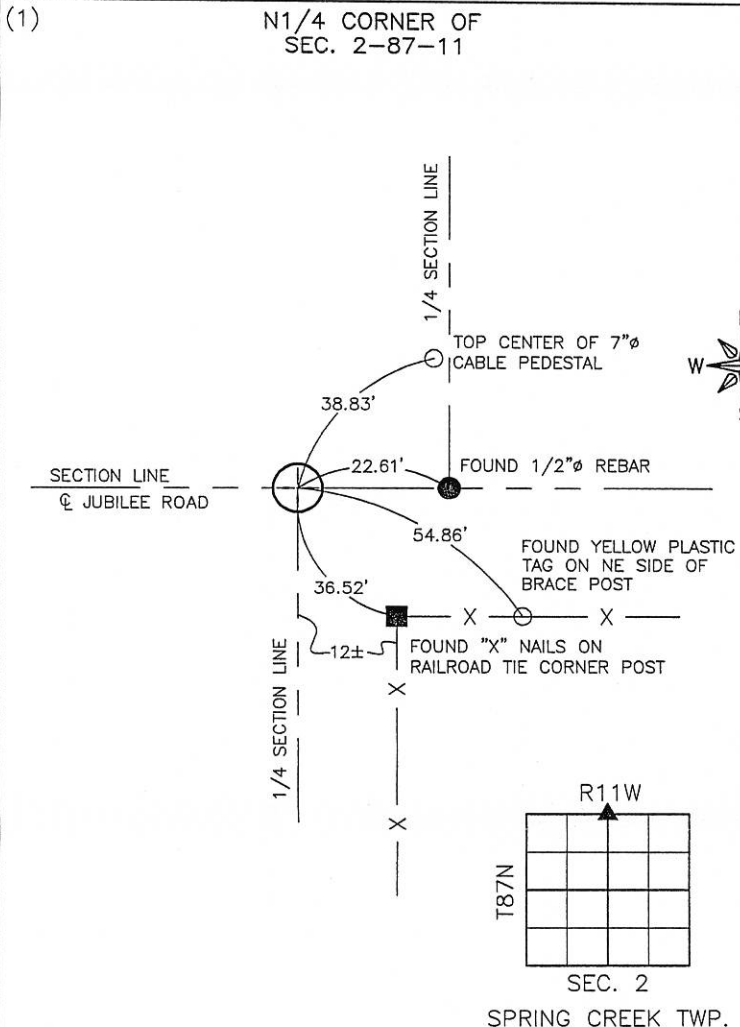

PREVIOUSLY RECORDED:  
AS FILE NUMBER 2015-00013778 IN COUNTY RECORDER'S OFFICE.

PURPOSE OF CERTIFICATE:  
RETIED MONUMENT DUE TO MISSING TIE FROM PREVIOUS CERTIFICATE.

MONUMENT DESCRIPTION AND ESTABLISHMENT:  
FOUND 5/8"Ø REBAR W/ALUMINUM CAP #12088 THAT WAS PLACED OVER A STANDARD CONCRETE MONUMENT WITH A BROKEN TOP. (SEE PREVIOUS CERTIFICATE)

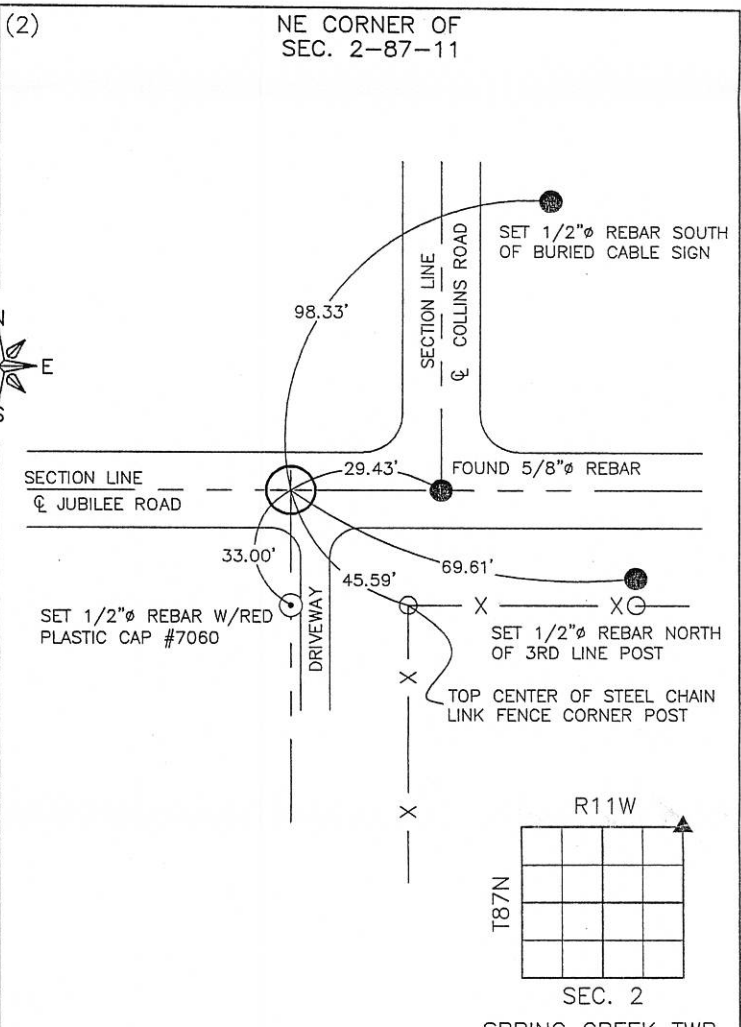

PREVIOUSLY RECORDED:  
NO PREVIOUS CERTIFICATE ON FILE.

PURPOSE OF CERTIFICATE:  
FOUND MONUMENT CALLED FOR ON A TIE SHEET FROM THE BLACK HAWK COUNTY ENGINEER'S OFFICE. THIS MONUMENT WAS ALSO USED ON A PLAT OF SURVEY RECORDED AS FILE #2013-00009579.

MONUMENT DESCRIPTION AND ESTABLISHMENT:  
FOUND 5/8"Ø REBAR.

CORNERS TO BE INDEXED

CORNER	SECTION	TOWNSHIP	RANGE
(1) N1/4	2	87N	11W
(2) NE	2	87N	11W



I hereby certify that this land surveying document was prepared and the related survey work was performed by me or under my direct personal supervision and that I am a duly licensed Land Surveyor under the laws of the State of Iowa.

Lyle G. Tekippe, P.E. & P.L.S.  
License Number: 7060  
My license renewal date is December 31, 2018.  
Sheets covered by this seal: Sheet 1

11-20-18  
Date

**FEHR GRAHAM**  
ENGINEERING & ENVIRONMENTAL  
© 2018 FEHR GRAHAM

ILLINOIS  
IOWA  
WISCONSIN

G:\C3D\18\18-969-LS-LICHTY\2-87-11CE.dwg

JOB NUMBER:  
18-969

SHEET NUMBER:  
1 of 1