



Doc ID: 004586410001 Type: GEN
Kind: CORNER
Recorded: 09/26/2011 at 02:48:17 PM
Fee Amt: \$0.00 Page 1 of 1
Black Hawk County Iowa
JUDITH A MCCARTHY RECORDER
File 2012-00005430

PREPARED BY: *BLACK HAWK COUNTY ENGINEERS OFFICE
316 E. FIFTH STREET, ROOM 211 WATERLOO, IOWA 50703

PH.# (319) 833-3008
FAX.# (319) 833-3139
SLSI 9-94
BHCO 03-09

UNITED STATES PUBLIC LAND SURVEY CORNER CERTIFICATE OF
Land Survey Monuments situated in Section 6, Township 87 N,
Range 11 W, of the Fifth Principal Meridian, BLACK HAWK County, Iowa.
Previously recorded in FEE Book 2005, Page 10419, in County Recorder's Office.

(Show reason for preparing this certificate): The corner monument has been Replaced or Modified, per Ia. Code 355.11(1)(c)
(Evidence and detailed procedures used in establishing the corner position(s) and monumentation found or placed.)



Monument Description and Remarks: E. 1/4 COR.
CORNER RESET FOR COLD-IN-PLACE RECYCL. & H.M.A. RESURF. PROJECT LFM-121--7X-07.
PRIOR TO RESURF. PROJECT, FOUND 5/8" REBAR PER CURRENT RECORD AND TEMP. REF.
COR. LOCATION PER RTK GPS, AFTER 4" DP. MILL (RECYCLE), SOUNDING REMAINED @ +/-
RTK REFERENCE LOCATION & EXCAVATED TO ±0.70' DEEP & FND. BENT #5 REBAR x 6"L
AND PULLED. FAINT SOUNDING STILL REMAINED @ +/- LOCATION, w/ NO FURTHER
EXCAVATION. P.V.M.T. RESURFACED w/+3" H.M.A. SURFACE COURSE, THEN RESET CORNER
WITH 5/8" (#5) x 6"L. REBAR LOCATED @ 0.20' EAST OF C.L. H.M.A JOINT AND ALIGNED
WITH REMNANT FENCE TO WEST. DELF. (CORNER) ANGLE DENOTED FOR SECTION LINE TO
N./S. PER COGO OF RTK GPS MEAS. CORNERS (AS OBSERVED).

PLAN VIEW
"NOT TO SCALE"

BHco Hist. Ties: BK. #1000 p. 06 T87-R11
FIELD BOOK: Ties per Topcon 7003i #Z0115

(Show a minimum of three reference ties to durable physical objects, relevant monuments and physical conditions that will enable recovery of the corner.)


- 1.) TIES PER EDM MEASURE IN EITHER PRISM "OR" NON-PRISM MODE, WHILE UTILIZING "INDIRECT" MEASURE, WITH ALL DISTANCES PLUMB/HORIZ. (H.D), UNLESS DENOTED.
- 2.) SECTION LINE MEASURE REFERS TO "LOCAL GROUND" DIST. AND INCLUDES ELLIPSOID (COMBINED) SCALE FACTOR FROM S.P.C. GRID INVERSE (AS OBSERVED), PER AVG. SCALE FACTOR = 1.000079092076.

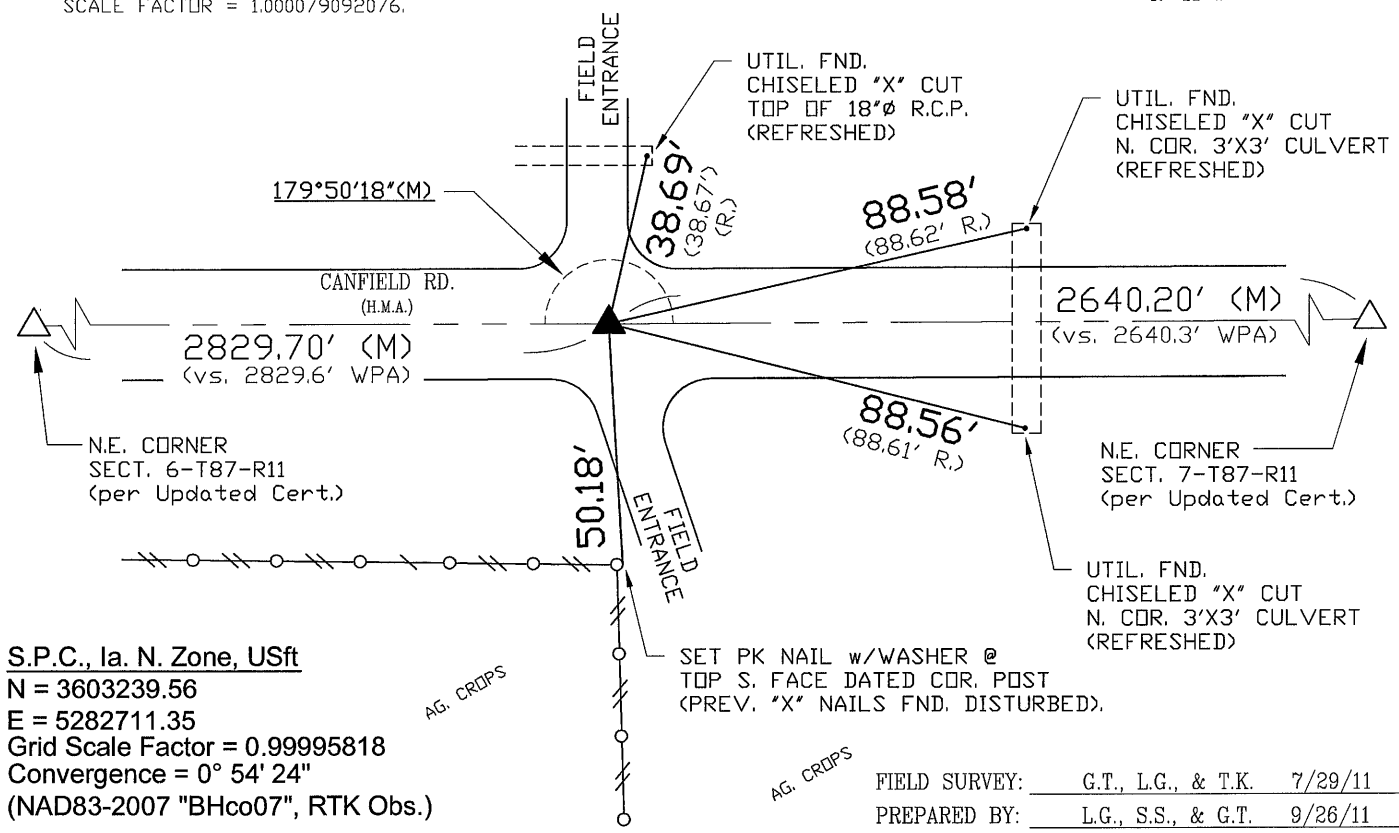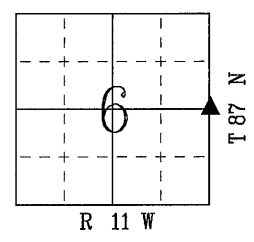

S.P.C., Ia. N. Zone, USft
N = 3603239.56
E = 5282711.35
Grid Scale Factor = 0.99995818
Convergence = 0° 54' 24"
(NAD83-2007 "BHco07", RTK Obs.)

FIELD SURVEY: G.T., L.G., & T.K. 7/29/11
PREPARED BY: L.G., S.S., & G.T. 9/26/11

CERTIFICATION

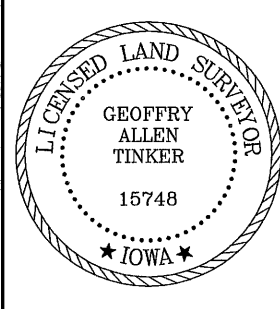

I hereby certify that this land surveying document was prepared and the related survey work was performed by me or under my direct personal supervision and that I am a duly licensed Land Surveyor under the laws of the State of Iowa.
Geoffrey Allen Tinker 9/26/2011 (date)
License Number 15748
My license renewal date is December 31, 2012
Pages or sheets covered by this seal: This Land Corner Certificate Only.

LIST CORNERS TO BE INDEXED

Corner	Section	Township	Range
E. 1/4 Cor.	6	87 N	11 W
W. 1/4 Cor.	5	87 N	11 W

INDEX OF ABBREVIATIONS

(M) = "Measured" Dimension
(P) = "Platted" Dimension
(R) = "Record" Dimension
(C) = "Calculated" Dimension
(IGS) = Iowa Geodetic Survey
"WPA" = Works Progress Admin. Survey
"G" = per George Miller Survey (BHco Surveyor 1858-1860)
"B" = per John Ball Survey (BHco Surveyor 1866-1891)
"N" = per Nathan Barber Survey (BHco Surveyor 1908-1931)
"NP" = Reflectless EDM Meas.
"MLM" = Indirect Measure
"CM" = Concrete Monument
"SM" = Survey Marker Spike/Tag
"PK" = PK/MAG Nail Brand Style