

PROOF FILED FOR RECORD MAR 15, 2006, AT 10:00A. M. FEE 1-5.00-1.00/

COMPARED

BLACK HAWK COUNTY RECORDER

KESS & ASSOCIATES INC

Kirk D. Eschliman, P.L.S. Iowa Lic. No. 9961, 723 Broadway Street, Waterloo, Iowa 50703 - Phone: 319-234-0509

UNITED STATES PUBLIC LAND SURVEY CORNER CERTIFICATE
OF


LAND SURVEY MONUMENTS SITUATED IN SECTION TWELVE (12), TOWNSHIP EIGHTY-SEVEN (87) NORTH
RANGE ELEVEN (11) WEST, OF THE FIFTH PRINCIPAL MERIDIAN, BLACK HAWK COUNTY, IOWA.
PREVIOUSLY RECORDED IN (NOT PREVIOUSLY RECORDED) (BOOK, PAGE, DOCUMENT NUMBER, ETC.) IN THE COUNTY RECORDER'S OFFICE.

(SHOW REASON FOR PREPARING THIS CERTIFICATE, THE EVIDENCE AND DETAILED PROCEDURES USED IN ESTABLISHING THE CORNER POSITIONS AND MONUMENTATION FOUND OR PLACED.)

MONUMENT DESCRIPTION AND REMARKS:

CURRENT SECTION CORNER CERTIFICATE NOT ON FILE IN THE BLACK HAWK COUNTY RECORDER'S OFFICE.

FOUND HALF-INCH IRON BAR, LEANING TO THE SOUTHEAST, 0.5 FEET BELOW GRANULAR SURFACE AT THE INTERSECTION OF SPRING CREEK ROAD AND WELLMAN ROAD. FOR USE IN REFERENCED FIELD SURVEY, IN SW 1/4, SECTION 12.

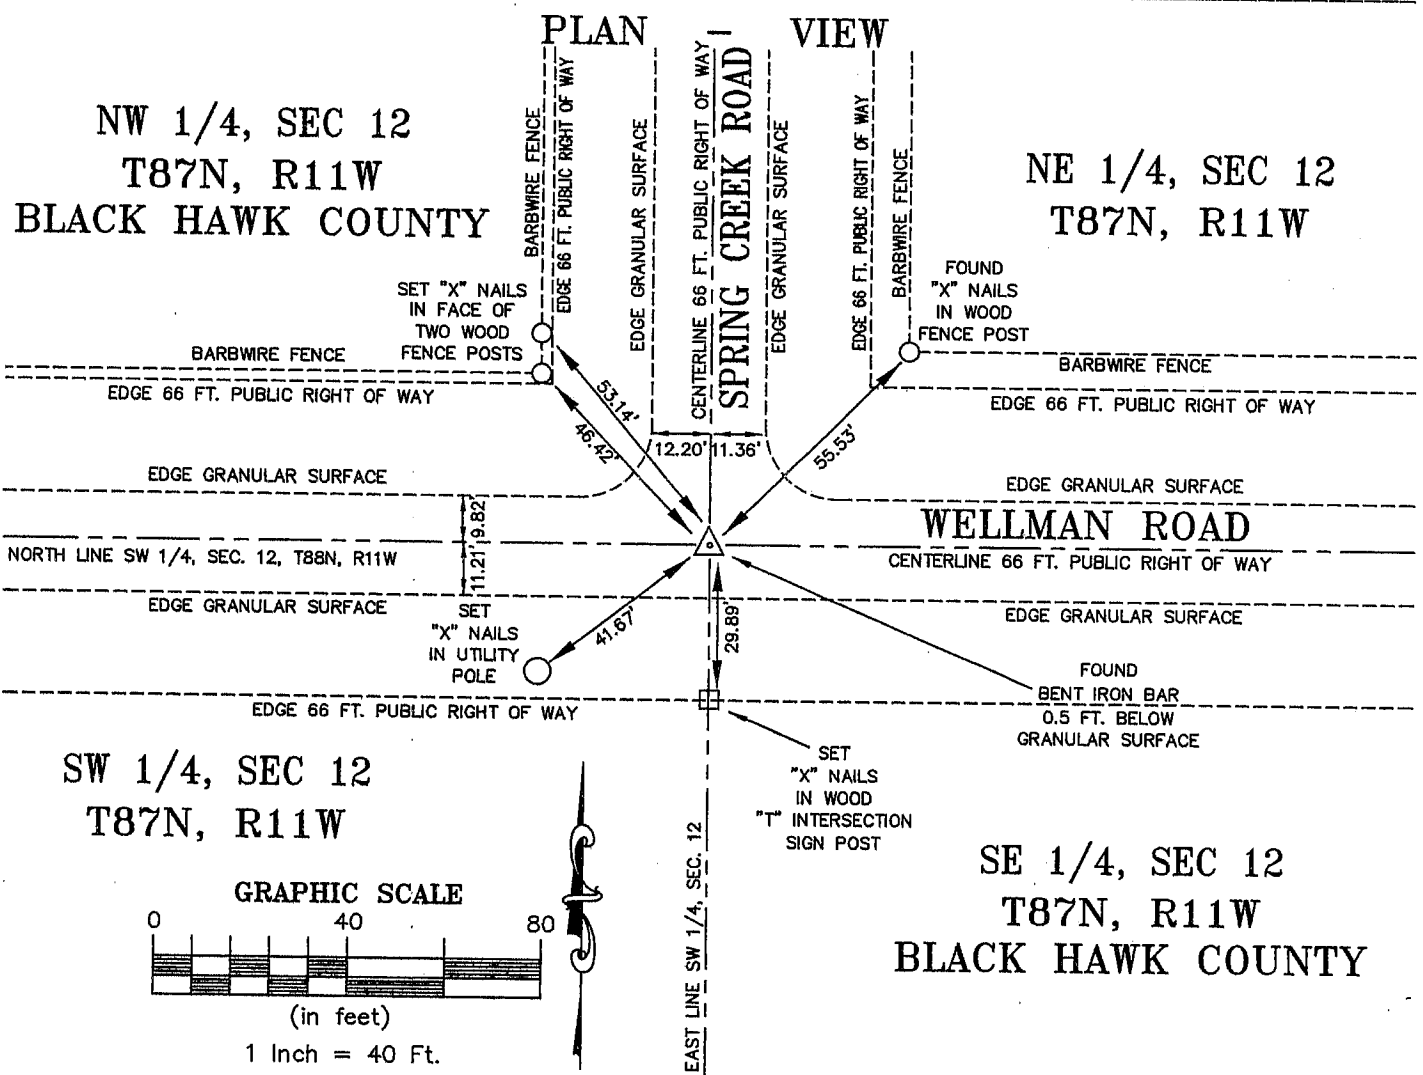

I HEREBY CERTIFY THAT THIS LAND SURVEYING DOCUMENT
WAS PREPARED AND RELATED SURVEY WORK WAS
PERFORMED BY ME OR UNDER MY DIRECT PERSONAL
SUPERVISION AND THAT I AM A DULY LICENSED LAND
SURVEYOR UNDER THE LAWS OF THE STATE OF IOWA.

 DATE: 03/13/2004
KIRK D. ESCHLIMAN, P.L.S. IOWA LIC. NO. 9961
MY LICENSE RENEWAL DATE IS DECEMBER 31, 2007
PAGES OR SHEETS COVERED BY THIS SIGNATURE & SEAL: SHEET 1 OF 1

FOR: PEGGY L. FISCHLS
13203 WELLMAN ROAD
LA PORTE CITY, IOWA 50651

REQ. BY: PEGGY FISCHERS
LA PORTE CITY, IOWA




KESS & ASSOCIATES, INC.
PROFESSIONAL LAND SURVEYORS : 723 BROADWAY, WATERLOO, IOWA 50703-5811

DATE: 03/07/2006 C.A.D.D. FILE:06A14SCC2.DWG PROJECT NO.: 06A14

List of corners to be indexed:

Corners	Section	Township	Range
CENTER	12	T87N	R11W

SECTION 12

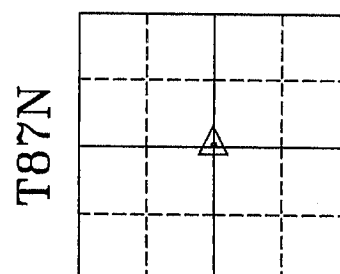

R11W