

*Great Plains Survey Inc 407 Sycamore St La Porte City Iowa 50651 319-342-4774



UNITED STATES PUBLIC LAND SURVEY CORNER CERTIFICATE
OF

Land Survey Monuments situated in Section 14 , Township 87 , Range 11 of the Fifth Principal Meridian, BLACK HAWK County, Iowa, previously recorded in N/A in County Recorder's Office. (Book, Page, Document Number, etc.)

Monument Description and Remarks:

FOUND NO CORNER CERTIFICATE ON FILE; USED SHOVEL AND METAL DETECTOR TO SEARCH AROUND CORNER POST, FOUND NO EVIDENCE OF MONUMENTATION AND NO TIES; HOLDING FENCE LINES NORTH AND WEST, SET 5/8" REBAR WITH ALUMINUM CAP #17929. ACCEPTED MONUMENT AS CENTER OF SECTION AND TIED OUT.

CENTER
SEC. 14-T87N-R11W

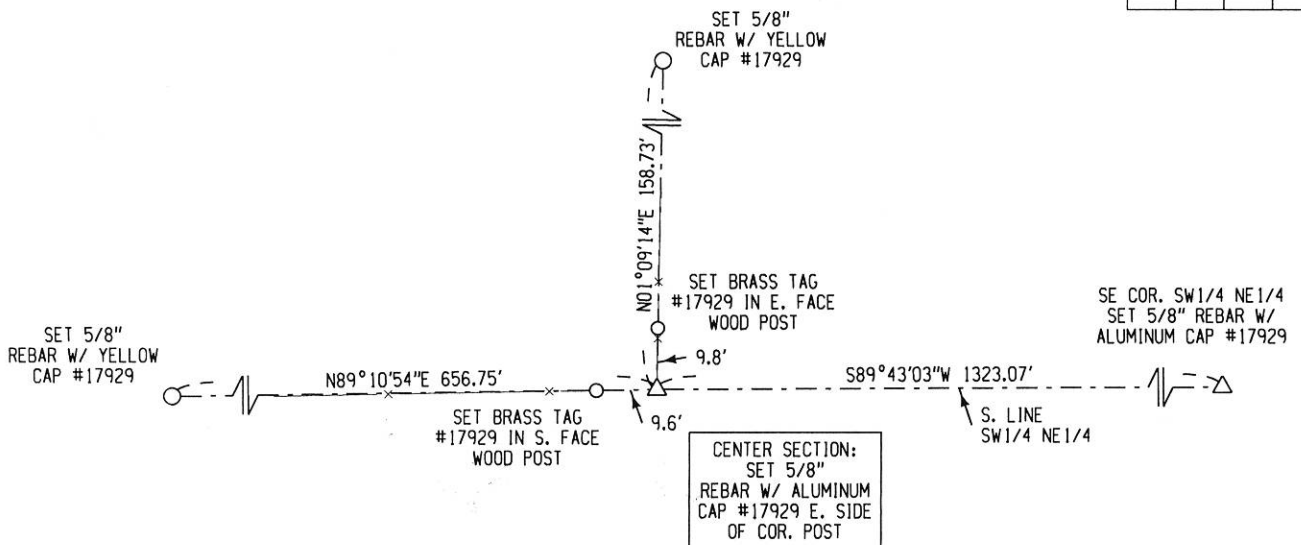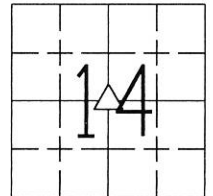

LIST CORNERS TO BE INDEXED			
CORNER	SECTION	TOWNSHIP	RANGE
CENTER	14	87N	11W



I hereby certify that this land surveying document was prepared and the related survey work was performed by me or under my direct personal supervision and that I am a duly licensed Land Surveyor under the laws of the State of Iowa.

Jeffrey R. Hutton 2/7/2020
JEFFREY R. HUTTON LICENSE NO. 17929 DATE

My license is subject to renewal on December 31, 2021.
This certification applies only to the page upon which it appears.

REASON FOR PREPARING CERTIFICATE:

- ☒ A) THERE IS NO CERTIFICATE FOR THE CORNER ON FILE WITH THE RECORDER OF THE COUNTY IN WHICH THE CORNER IS LOCATED.
☐ B) CORNER POSITION DIFFERS FROM THAT SHOWN IN THE PUBLIC RECORDS OF THE COUNTY IN WHICH THE CORNER IS LOCATED.
☐ C) THE CORNER MONUMENT HAS BEEN REPLACED OR MODIFIED.
☐ D) THE REFERENCE TIES REFERRED TO IN AN EXISTING PUBLIC RECORD ARE INCORRECT.

U.S. LAND SURVEY CORNER CERT.

PROJECT NAME
LANGE FARMSTEAD SPLIT



407 SYCAMORE ST.
LA PORTE CITY, IA 50651
(319)342-4774
Great Plains Survey, Inc.

DATE	DRAWN BY	CHECKED BY	APPROVED BY	REVISION DATE	SCALE	FIELD BOOK No.	PROJECT No.
02/06/2020	MJWH	JRH	JRH		NTS		