

SC
Misc

[Handwritten signature]

Nov 14, 1997 at
4:00 p
Misc
Recorded in Book 328
Page 97

9728

WAYNE CLAASSEN ENGINEERING AND SURVEYING, INC.
P.O. BOX 898 WATERLOO, IOWA 50704-0898

PHONE: (VOICE) 319-235-6294
(FAX) 319-235-0028

UNITED STATES PUBLIC LAND SURVEY CORNER CERTIFICATE


Land Survey Monuments situated in Section 17, Township 87N, Range R11W, of the Fifth Principal Meridian, BLACK HAWK County, Iowa.
Previously recorded in N/A in County Recorder's Office.
(book, page, document number, etc.)

(Show reason for preparing this certificate, the evidence and detailed procedures used in establishing the corner positions and monumentation found or placed.)

Monument Description and Remarks FOUND STD CONC. MONUMENT 4" DEEP DEL
B.H. COUNTY TIES. 112°0' REBAR ON NORTH SIDE OF MONUMENT.

PLAN - VIEW

(Show a minimum of three reference ties to durable physical objects, relevant monuments and physical conditions that will enable recovery of the corner.)

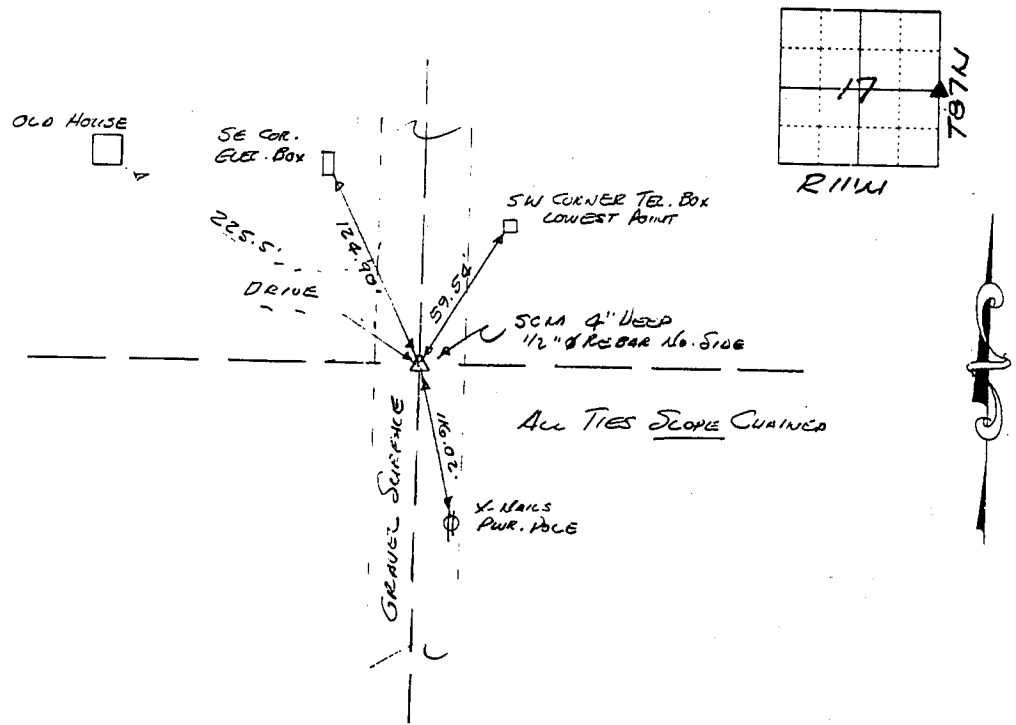


475-42

I hereby certify that the survey work was completed and this certificate was prepared by me or under my direct personal supervision and that I am a duly licensed land surveyor under the laws of the state of Iowa.

Signature: *[Handwritten signature]*
(Name typed or printed: F. WILLIAM KING)

Date: Nov. 14, 1997 Lic. No. 18033

SEAL

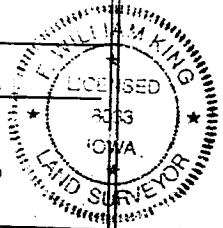

List Corners to be Indexed			
Corners	Section	Twp	Range
E1/4	17	87N	11W

BOOK 328 PAGE 097