

Jeffrey P. Helland, 1107 Technology Parkway, Cedar Falls, Iowa 50613-6951, (319)-266-0161

## UNITED STATES PUBLIC LAND SURVEY CORNER CERTIFICATE OF

LAND SURVEY MONUMENTS SITUATED IN SECTION NO. 17, TOWNSHIP NO. 87 NORTH, RANGE  
NO. 11 WEST OF THE FIFTH PRINCIPAL MERIDIAN, BLACK HAWK COUNTY, IOWA.  
PREVIOUSLY RECORDED IN 328 MISC. 97

(SHOW REASON FOR PREPARING THIS CERTIFICATE, THE EVIDENCE AND DETAILED PROCEDURES USED IN ESTABLISHING THE  
CORNER POSITIONS AND MONUMENTATION FOUND OR PLACED.)


### MONUMENT DESCRIPTION AND REMARKS:

328 MISC. 97 REFERENCE TIES HAVE CHANGED. SURVEY COMPLETED IN THE NW 1/4 OF SEC. 16-T87N-R11W.

→ **E 1/4 CORNER:** AUDITOR'S SURVEY RECORD BK 1 PG 143 DATED 1/3/1867 CALLS FOR [STONE]. BLACK HAWK COUNTY  
ENGINEER REFERENCE TIES DATED 9/16/1982 CALL FOR [FOUND MON. 4" DEEP 1/2" REBAR SET ON N. SIDE]. USPLSCC 328  
MISC. 97 DATED 11/14/1997 CALLS FOR [FOUND STD. CONC. MONUMENT 4" DEEP PER B.H. COUNTY TIES. 1/2" Ø REBAR ON  
NORTH SIDE OF MONUMENT]. FOUND STD. CONCRETE MONUMENT 0.3' DEEP WITH BENT NO. 4 REBAR ON NORTH SIDE  
CORRESPONDING TO REMAINING TIES. UTILIZED SAID CONCRETE MONUMENT AS CORNER.


### PLAN VIEW

(SHOW A MINIMUM OF THREE REFERENCE TIES TO DURABLE PHYSICAL OBJECTS, RELEVANT MONUMENTS AND PHYSICAL  
CONDITIONS THAT WILL ENABLE RECOVERY OF THE CORNER.)

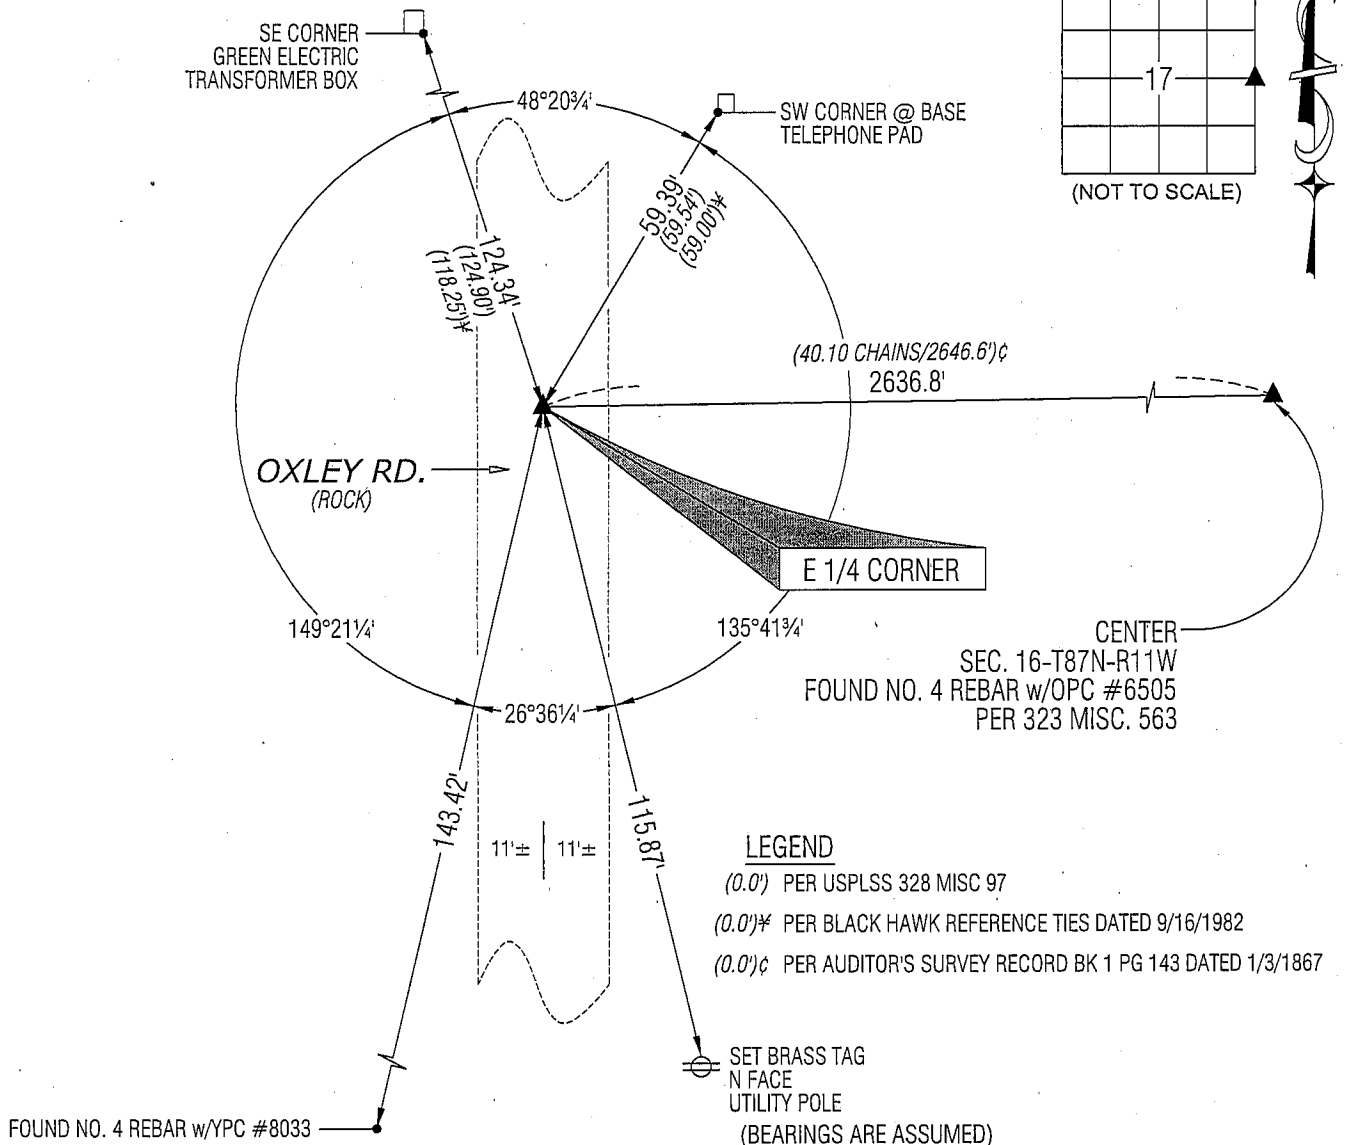

**HELLAND ENGINEERING & SURVEYING, LTD.**  
1107 Technology Parkway  
Cedar Falls, Iowa 50613-6951  
(319)-266-0161

SHINER = 8D NAIL & 1 5/16" Ø METAL SHINER  
BRASS TAG = 13/16" Ø BRASS TAG  
OPC = PLASTIC CAP (O=ORANGE, R=RED, Y=YELLOW)  
(00') RECORDED AS FILE NAME: 09-104C2.DWG

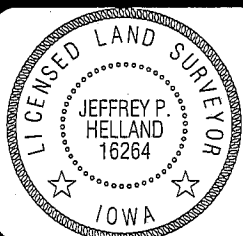

I hereby certify that this land surveying document was prepared  
and the related survey work was performed by me or under my  
direct personal supervision and that I am a duly licensed Land  
Surveyor under the laws of the State of Iowa.

*Jeffrey P. Helland* 1/29/09  
Jeffrey P. Helland  
License Number 16264  
My license renewal date is December 31, 2009.  
All pages or sheets are covered by this seal except:

### LIST CORNERS TO BE INDEXED

CORNER	SECTION	TOWNSHIP	RANGE
E 1/4 CORNER	17	87N	11W
W 1/4 CORNER	16	87N	11W