

SC
Misc

4:00 P
Misc

Nov 14

97

328

96

9727

1-5.00/

CLAASSEN ENGINEERING

WAYNE CLAASSEN ENGINEERING AND SURVEYING, INC.
P.O. BOX 898 WATERLOO, IOWA 50704-0898

PHONE: (VOICE) 319-235-6294
(FAX) 319-235-0028

UNITED STATES PUBLIC LAND SURVEY CORNER CERTIFICATE

Land Survey Monuments situated in Section 17, Township 87N, Range 11W, of the Fifth Principal Meridian, BLACK HAWK County, Iowa.


Previously recorded in N/A in County Recorder's Office.
(book, page, document number, etc.)

(Show reason for preparing this certificate, the evidence and detailed procedures used in establishing the corner positions and monumentation found or placed.)

Monument Description and Remarks 5 1/4 COR. FOUND BASE OF SIGN (BROKEN) WITH 1/2" REBAR ON WEST SIDE 12" DEEP IN CULTIVATED FIELD PER CES SURVEY OF 1979. USED CENTER OF BRICK MONUMENT FOR CCE 'ER.

PLAN - VIEW

(Show a minimum of three reference ties to durable physical objects, relevant monuments and physical conditions that will enable recovery of the corner.)

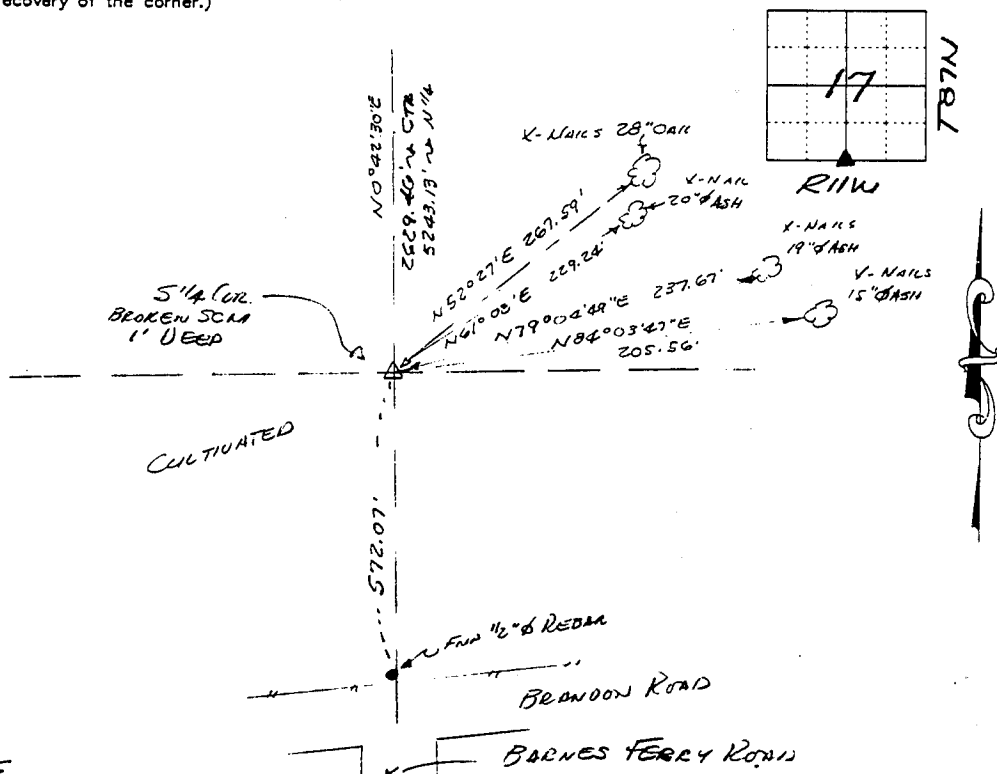


475-45

I hereby certify that the survey work was completed and this certificate was prepared by me or under my direct personal supervision and that I am a duly licensed land surveyor under the laws of the state of Iowa.

Signature: William King
(Name typed or printed: WILLIAM KING)

Date: Nov. 14, 1997 Lic. No. 8033

SEAL

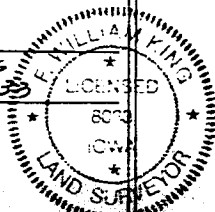

List Corners to be Indexed

Corners	Section	Twp	Range
<u>5/4</u>	<u>17</u>	<u>87N</u>	<u>11W</u>

BOOK 328 PAGE 096