

SC
MISC
INDEX
MARGIN
PROOF
COMPARE

BLACK HAWK COUNTY IOWA:SS
Filed for record JUN 1, 2000 at
4:00 P.M. and recorded in Book 338
of MISC Page 616
Cathie S. Lass RECORDER
FEE 1-5.00/
WAYNE CLAASSEN ENGINEERING & SURVEYING INC.

WAYNE CLAASSEN ENGINEERING AND SURVEYING, INC.
P.O. BOX 898 WATERLOO, IOWA 50704-0898

PHONE: (VOICE) 319-235-6294
(FAX) 319-235-0028

UNITED STATES PUBLIC LAND SURVEY CORNER CERTIFICATE


Land Survey Monuments situated in Section 17, Township 87N, Range 11W, of the Fifth Principal Meridian, BLACK HAWK County, Iowa.
Previously recorded in N/A in County Recorder's Office.
(book, page, document number, etc.)

(Show reason for preparing this certificate, the evidence and detailed procedures used in establishing the corner positions and monumentation found or placed.)

Monument Description and Remarks FOUND 1/2" Ø REBAR IN ASPHALT PAVING - (BRANDON ROAD) AT SE COR SEC. 17 PER COUNTY TIES. WHITE CROSS PAINTED AT THIS POINT.

PLAN - VIEW

(Show a minimum of three reference ties to durable physical objects, relevant monuments and physical conditions that will enable recovery of the corner.)

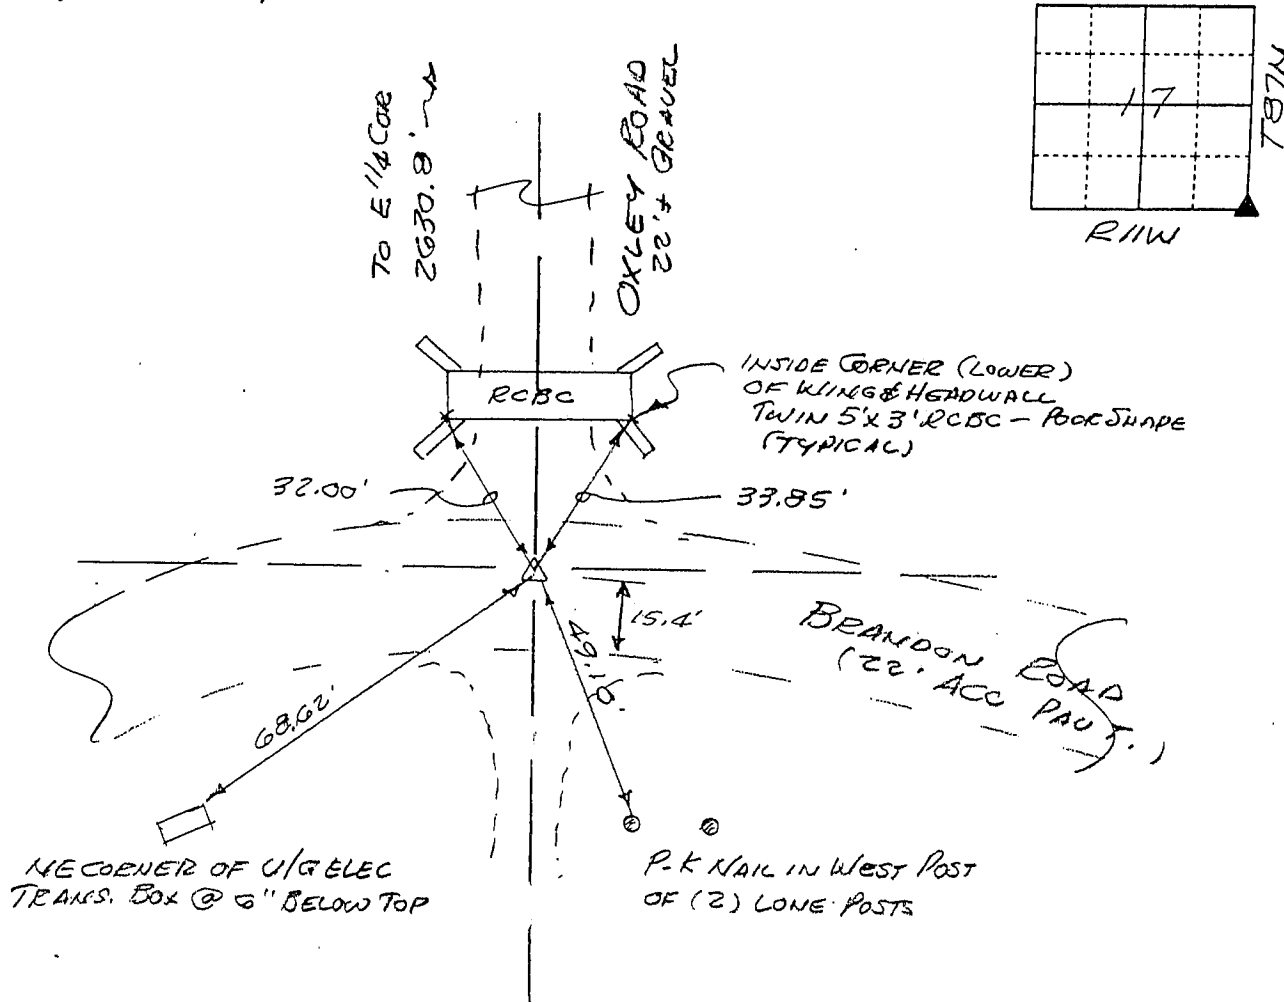

4/10-13

I hereby certify that the survey work was completed and this certificate was prepared by me or under my direct personal supervision and that I am a duly licensed land surveyor under the laws of the state of Iowa.

Signature: *F. William King*
(Name typed or printed:) F. WILLIAM KING
Date: 5-31-2000 Lic. No. 8033

List Corners to be Indexed

Corners	Section	Twp	Range
SE	17	87N	11W

