
Doc ID: 005055500001 Type: GEN Kind: CORNER Recorded: 02/05/2013 at 11:12:14 AM Fee Amt: \$7.00 Page 1 of 1 Black Hawk County Iowa JUDITH A MCCARTHY RECORDER

File 2013-00016387

Paul H. Helland, 1107 Technology Parkway, Cedar Falls, Iowa 50613-6951, (319)-266-0161

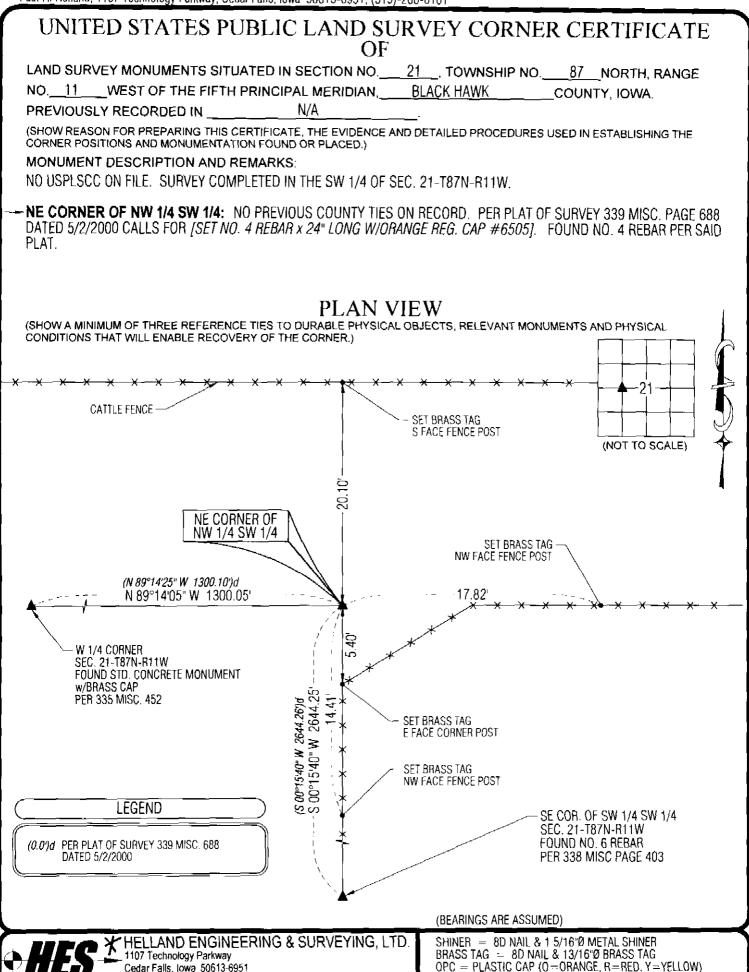

MGINEEA

HELLAND 6505

₹wo\Ş

Cedar Falls, Iowa 50613-6951 (319)-266-0161

Paul H. Helland

I hereby certify that this land surveying document was prepared and the related survey work was performed by me or under my direct personal supervision and that I am a duly licensed Land Surveyor under the laws of the State of lowa.

License Number 6505 My license renewal date is December 31, 2013, All pages or sheets are covered by this seal except:

OPC = PLASTIC CAP (O = ORANGE, R = RED. Y = YELLOW)
(00') RECORDED AS FILE NAME: 13-102-51.DWG

LIST CORNERS TO BE INDEXED CORNER SECTION TOWNSHIP RANGE NE COR. NW 1/4 SW 1/4 SE COR. SW 1/4 NW 1/4 21 87N 11W 21 SW COR. SE 1/4 NW 1/4 87N 11W NW COB NE N4 SW 1/4 : 21 13-00016387 Seq:

12 mm.

7.00