



*Great Plains Survey Inc 407 Sycamore St La Porte City Iowa 50651

UNITED STATES PUBLIC LAND SURVEY CORNER CERTIFICATE
OF

Land Survey Monuments situated in Section 23 , Township 87N , Range 11W of the Fifth Principal Meridian, BLACK HAWK County, Iowa, previously recorded in N/A in County Recorder's Office. (Book, Page, Document Number, etc.)

Monument Description and Remarks:
USING FIELD NOTES DATED 1940, FOUND IN FIELD BOOK No. 209, PAGE 32 IN THE OFFICE OF THE BLACK HAWK COUNTY ENGINEER, DUG A HOLE AT THE INTERSECTION OF EAST-WEST FENCELINE AND APPROXIMATE CENTERLINE OF ROADWAY. TIES SHOWN ON SAID BOOK AND PAGE DO NOT EXIST. PROBED AND FOUND A LARGE LIMESTONE IN ROUGH SHAPE 23" DEEP, DUG AROUND STONE TO FIND CENTER OF MASS; SET A 5/8" REBAR ABOVE CENTER OF STONE, ACCEPTED AS CORNER, SET TIES AND TIED OUT.

PLAN - VIEW

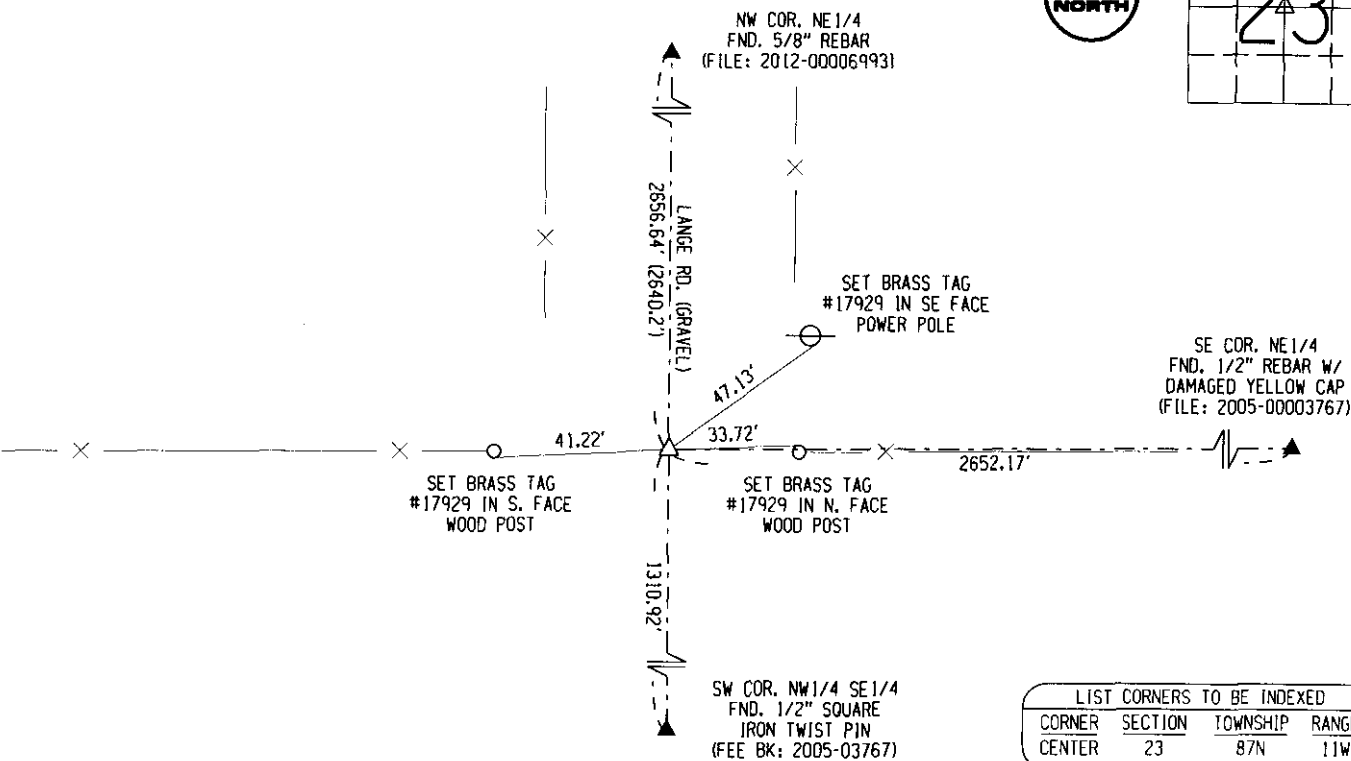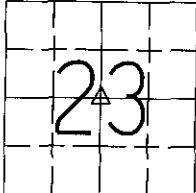


LIST CORNERS TO BE INDEXED			
CORNER	SECTION	TOWNSHIP	RANGE
CENTER	23	87N	11W



I hereby certify that this land surveying document was prepared and the related survey work was performed by me or under my direct personal supervision and that I am a duly licensed Land Surveyor under the laws of the State of Iowa.
Jeffrey R. Hutton 4/2/19
JEFFREY R. HUTTON LICENSE NO. 17929 DATE
My license is subject to renewal on December 31, 2019.
This certification applies only to the page upon which it appears.

- REASON FOR PREPARING CERTIFICATE:
- ☒ A) THERE IS NO CERTIFICATE FOR THE CORNER ON FILE WITH THE RECORDER OF THE COUNTY IN WHICH THE CORNER IS LOCATED.
 - ☐ B) CORNER POSITION DIFFERS FROM THAT SHOWN IN THE PUBLIC RECORDS OF THE COUNTY IN WHICH THE CORNER IS LOCATED.
 - ☐ C) THE CORNER MONUMENT HAS BEEN REPLACED OR MODIFIED.
 - ☐ D) THE REFERENCE TIES REFERRED TO IN AN EXISTING PUBLIC RECORD ARE INCORRECT.

RECORDED	SHEET NAME	U.S. LAND SURVEY CORNER CERT.			 GPS 407 SYCAMORE ST. LA PORTE CITY, IA 50651 (319)342-4774 Great Plains Survey, Inc.
	PROJECT NAME	BURKE FARMSTEAD SPLIT			
DATE	DRAWN BY	CHECKED BY	APPROVED BY	SCALE	PROJECT No.
04/02/19	MJWH	JRH	JRH	NFS	File Number: 2019-00014647 Seq: 1