



Doc ID: 004565290001 Type: GEN
Kind: CORNER
Recorded: 09/01/2011 at 01:23:20 PM
Fee Amt: \$7.00 Page 1 of 1
Black Hawk County Iowa
JUDITH A MCCARTHY RECORDER
File **2012-00003885**

Env
Prepared By: Steven N. Zeets, L.S. #18377 Foth Infrastructure & Environment, LLC
3950 River Ridge Drive NE, Suite A Cedar Rapids, Iowa 52402 Phone: (319) 365-9565
UNITED STATES PUBLIC LAND SURVEY CORNER CERTIFICATE
OF


Land Survey Monuments situated in Section 29, Township 87, Range 11, of the Fifth Principal Meridian, BLACK HAWK County, Iowa.
Previously recorded in _____ in County Recorders Office.

(book, page, document number, etc.)
(Show reason for preparing this certificate, the evidence and detailed procedures used in establishing the corner positions and monumentation found or placed)

Monument Description and Remarks: SW CORNER SE 1/4 SE 1/4 WAS DESTROYED DURING CONSTRUCTION AND RESET
SE CORNER - SET 5" ASPHALT NAIL IN ASPHALT PAVEMENT OVER TOP FOUND 5/8" PINCHED PIPE PER BLACK HAWK COUNTY SECONDARY ROAD PROJECT L-1016--73-07
RE-SET SW CORNER SE 1/4 SE 1/4 - SET 5" ASPHALT NAIL IN ASPHALT PAVEMENT PER BLACK HAWK COUNTY SECONDARY ROAD PROJECT L-1016--73-07


PLAN - VIEW

(Show a minimum of three reference ties to durable physical objects, relevant monuments and physical conditions that will enable recovery of the corner.)

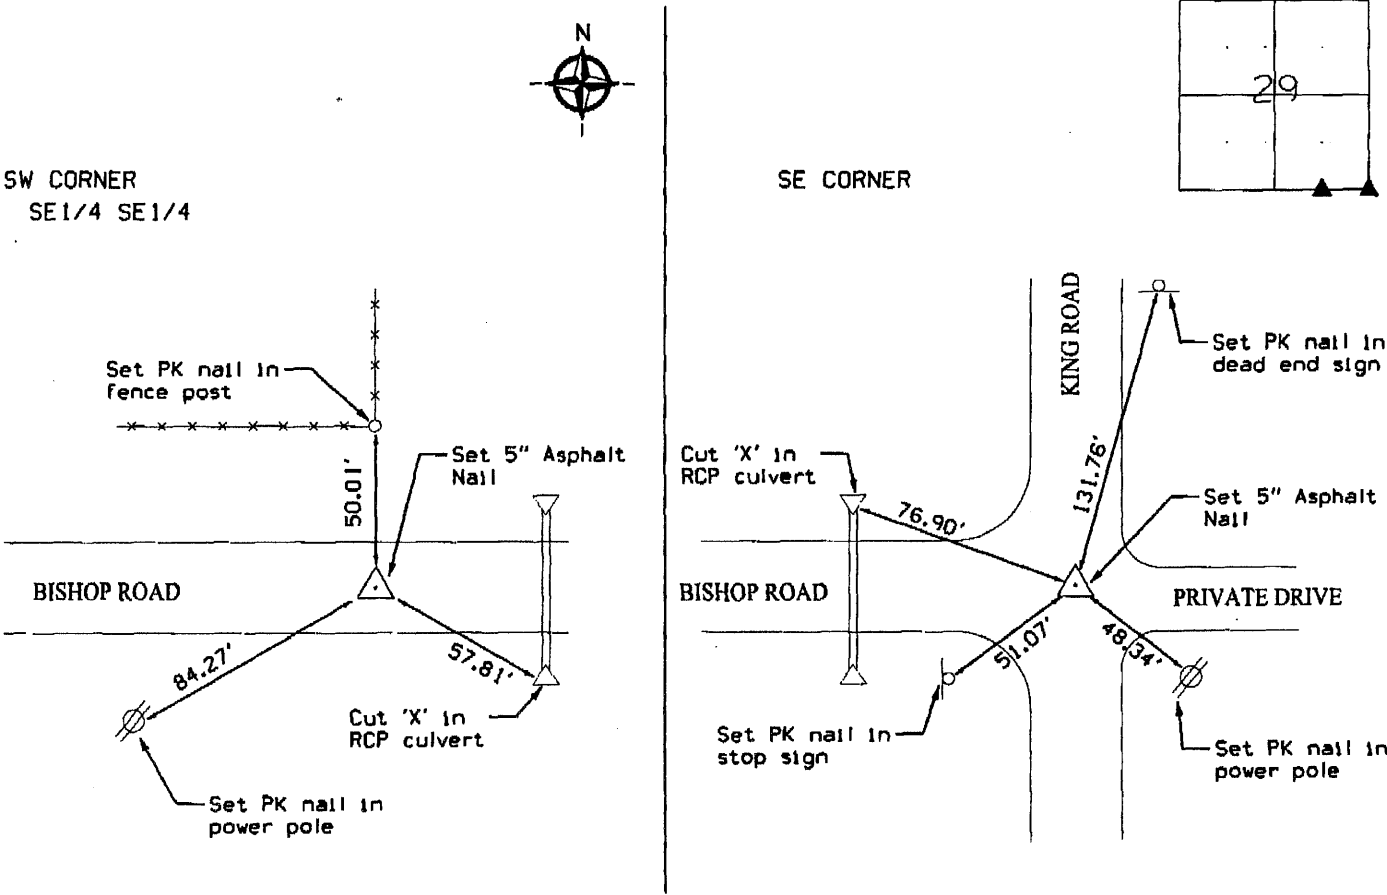

I hereby certify that this land surveying document was prepared and the related survey work was performed by me or under my direct personal supervision and that I am a duly licensed Land Surveyor under the laws of the State of Iowa

Signature: Steven N. Zeets Date: 8/16/11
Printed or typed name: Steven N. Zeets
License number: #18377
My license renewal date is December 31, 2012
Pages or sheets covered by this seal: 1 of 1

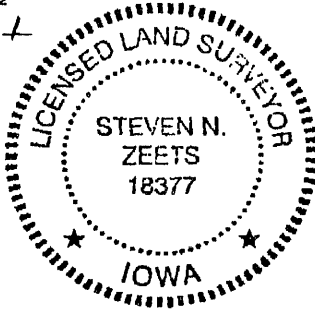

List Corners to be Indexed

Corners	Section	Twp	Range
SE CORNER	29	87	11
SW CORNER SE 1/4 SE 1/4	29	87	11

(7.00)