


004989820001 Type: GEN CORNER RING: CORNER
Recorded: 12/04/2012 at 01:10:31 PM
Fee Amt: \$0.00 Page 1 of 1
Black Hawk County Iowa
JUDITH A MCCARTHY RECORDER

File 2013-00011396

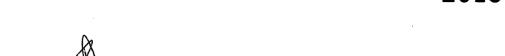

PH.# (319) 833-3008 FAX.# (319) 833-3139 BLACK HAWK COUNTY ENGINEERS OFFICE PREPARED BY: 316 E. FIFTH STREET, ROOM 211 WATERLOO, IOWA 50703 UNITED STATES PUBLIC LAND SURVEY CORNER CERTIFICATE OF Land Survey Monuments situated in Section_ 30 Range 11 W, of the Fifth Principal Meridian, BLACK HAWK County, Iowa. Previously recorded in Fee Book N/A, Page N/A, in County Recorder's Office. (Show reason for preparing this certificate): There is No Certificate for the corner on file with County Recorder, per Ia. Code 355.11(1)(a). (Evidence and detailed procedures used in establishing the corner position(s) and monumentation found or placed.) Monument Description and Remarks: C.W. 1/16th CORNER:

CORNER RESET & TIES UPDATED PER H.M.A. RESURF. PROJECT (EXTENSION) TO BHCO. PROJ.

#LFM-1109--7X-07, WITH NO CURRENT CERT. OF RECORD. CORNER HIST. REFERENCED AS PART OF PLAT OF SURVEY IN FILE 2012-006261 OF RECORD, IN ADDITION TO PLAT OF SURVEY PER MISC. BK. 313 p.360 (PLS 12088), PRIOR TO RESURF., FOUND #5 REBAR (TOP BENT DUE TO MILLING) AND TEMP. REF. CORNER LOCATION (TRUED) PER RTK GPS. AFTER 2" DEEP MILL (OF EXIST. ACC) & RESURF. w/+2.5" INTERMED. AND +2" SURFACE COURSES, RESET CORNER WITH #5 (5/8") REBAR x ±6" L. LOCATED (±) IN N/S H.M.A. PAVING JOINT AND ALIGNED (±) WITH EXISTING FENCE TO EAST OF CORNER. CORNER LOCATED @ 103.9" NORTH OF P.T. (DISTANCE PER 1961 GRADING PLANS) FOR HORIZ. CURVE TO SOUTH. BHco Hist. Ties: Geom. 1961 Grading Plans PLAN VIEW FIELD BOOK: TopSurv Proj. & 7000i #Z0115 "NOT TO SCALE" (Show a minimum of three reference ties to durable physical objects, relevant monuments and physical conditions that will enable recovery of the corner.) TIES TO #5 REBAR PER RTK GPS
MEASURE, WITH REMAINING TIES PER
EDM MEASURE IN NON-PRISM MODE
WHILE UTILIZING "INDIRECT"
MEASURE. ALL DISTANCES ARE W. 16th COR. (N.) 30-T87-R11, 1.> FILE 없 2013-0010138 83 MEASURE. ALL DIST PLUMB/HORIZ. (H.D.). BRANDON SET #5 RBR (±30" L.) w/ T-POST LOC. SECTION LINE MEASURE REFERS 2.) i S TO 'LOCAL GROUND' DIST. AND INCLUDES ELLIPSDIDAL (COMBINED) SCALE FACTOR FROM S.P.C. GRID 89°14'04" (M) R 11 W 2637, FROM REF. TIE. SCALE FACTUR FRUM S.P.C. GRID INVERSE (AS OBSERVED), PER AV SCALE FACTUR = 1.00007063223× FROM GPS MON. #63 PUB. VALUES. (GPS MON. #94-063 DESTROYED) (vs. 1332,09′ P) (TYP.) 1332.10′ 69,92 S.P.C., Ia. N. Zone, USft 180 N=3582132.24' **"**B" E=5279122.54' (NAD83-2007 "BHco07", RTK Obs.) ڰٳڡۣٛ CENTER 30-T87-R11, per FILE # 2012-008348 $\bar{\infty}$ (103,9' P.T. FND. #5 RBR. & ReSet PK w/Mtl. CURVE DATA:
Delta: 89°39′ LT. (HELD)
D°CURVE: 10° REF. TIE DETAILS Washer = FOUND SMALL (MINI) P.K. NAIL @ TOP OF FENCE END POST. ALSO REF. FOUND DTD. NAIL w/SHINER LOC. S.W. FACE @ 49.47', WITH ADDITIONAL FND. "X" NAILS NEAR BASE NOT UTILIZED. 0, <u>Sta. 44+65.3</u> 43+44.8 Back P.T. R.: 573.0' (HELD) (1961 Grading) T.: 569.5 L. : 896.5' 34+48,3 CH.: 807.87' \do', "B" = 2nd FNC, POST (UNSTABLE) 580,77' (M) "C" = SET P.K. NAIL @ TOP DF FENCE POST. L.P.C. (vs. 581.08' P.) Misc. 336 p.863 HELD ALSO REF. FOUND DTD. NAIL W/SHINER LOC. S.W. FACE @ 69.71', WITH FND. <-P.I. "X" NAILS NEAR BASE NOT UTILIZED. (Not checked FND. 30d NAIL @ FND. #4 RBR., □.P.C. #7811 @ N. FACE SQ. COR. 1.8' East of CALC. P.C. per H.C. Data & RESET per CALC loc. in field) FIELD SURVEY: G.T. & S.S. & RESET per CALC. CH. w/ PK & Washer.

CERTIFICATIONLAND GEOFFRY TINKER 15748 * AWOI *

I hereby certify that this land surveying document was prepared and the related survey work was performed by me or under my direct personal supervision and that I am a duly licensed Land Surveyor under the laws of the State of Iowa.

Weaffry Geoffry Allen Tinker 12 104 4/2012 (date)

15748 License Number_

My license renewal date is December 31, 2012

Pages or sheets covered by this seal:

This Land Corner Certificate Only

LIST CORNERS TO BE INDEXED

Corner Section -Township Range C.W. 16th 87 N 11 W

G.T.

12/4/12

INDEX OF ABBREVIATIONS

"Measured Dimension

"NP" = Reflectorless EDM Meas.
"MLM" = Indirect Measure
"CM" = Concrete Monument
"SM" = Survey Marker Spike/Tag
"PK" = PK/MAG Nail Brand Style (M) = (P) = (R) = (C) = "IGS" "WPA" = "Measured" Dimension
= "Platted" Dimension
= "Record" Dimension
= "Calculated" Dimension
= lowa Geodetic Survey
= Works Progress Admin. Survey
per George Miller Survey (BHco Surveyor 1858–1860)
per John Ball Survey (BHco Surveyor 1908–1931)
per Nathan Barber Survey


PREPARED BY: