

SC ✓
Misc ✓
INDEX ✓
MARGIN ✓
PROOF
COMPARE

BLACK HAWK COUNTY IOWA: SS
Filed for record Jun 25, 19 97 at 4:00P.M. and recorded in Book 326 of Misc Page 69

24294

Wayne Claassen Recorder
Fee 1-5.00/

WAYNE CLAASSEN ENGINEERING AND SURVEYING INC

WAYNE CLAASSEN ENGINEERING AND SURVEYING, INC.
P.O. BOX 898 WATERLOO, IOWA 50704-0898

PHONE: (VOICE) 319-235-6294
(FAX) 319-235-0028

UNITED STATES PUBLIC LAND SURVEY CORNER CERTIFICATE


Land Survey Monuments situated in Section 31, Township 87N, Range 11W, of the Fifth Principal Meridian, Black Hawk County, Iowa
Previously recorded in N/A in County Recorder's Office
(book, page, document number, etc.)

(Show reason for preparing this certificate, the evidence and detailed procedures used in establishing the corner position and monumentation found or placed.)

Monument Description and Remarks SW CORNER. Dug 3' x 1 1/2' Deep Hole, used prod rod to 5' deep - hit nothing. Set 1/2" x 24" rebar using county & WPA 1939 Ties
DISTANCE TO W 1/4 CORNER 2630.86 - 1939 WPA DIST. = 2630.90'

PLAN - VIEW

(Show a minimum of three reference ties to durable physical objects, relevant monuments and physical conditions that will enable recovery of the corner.)

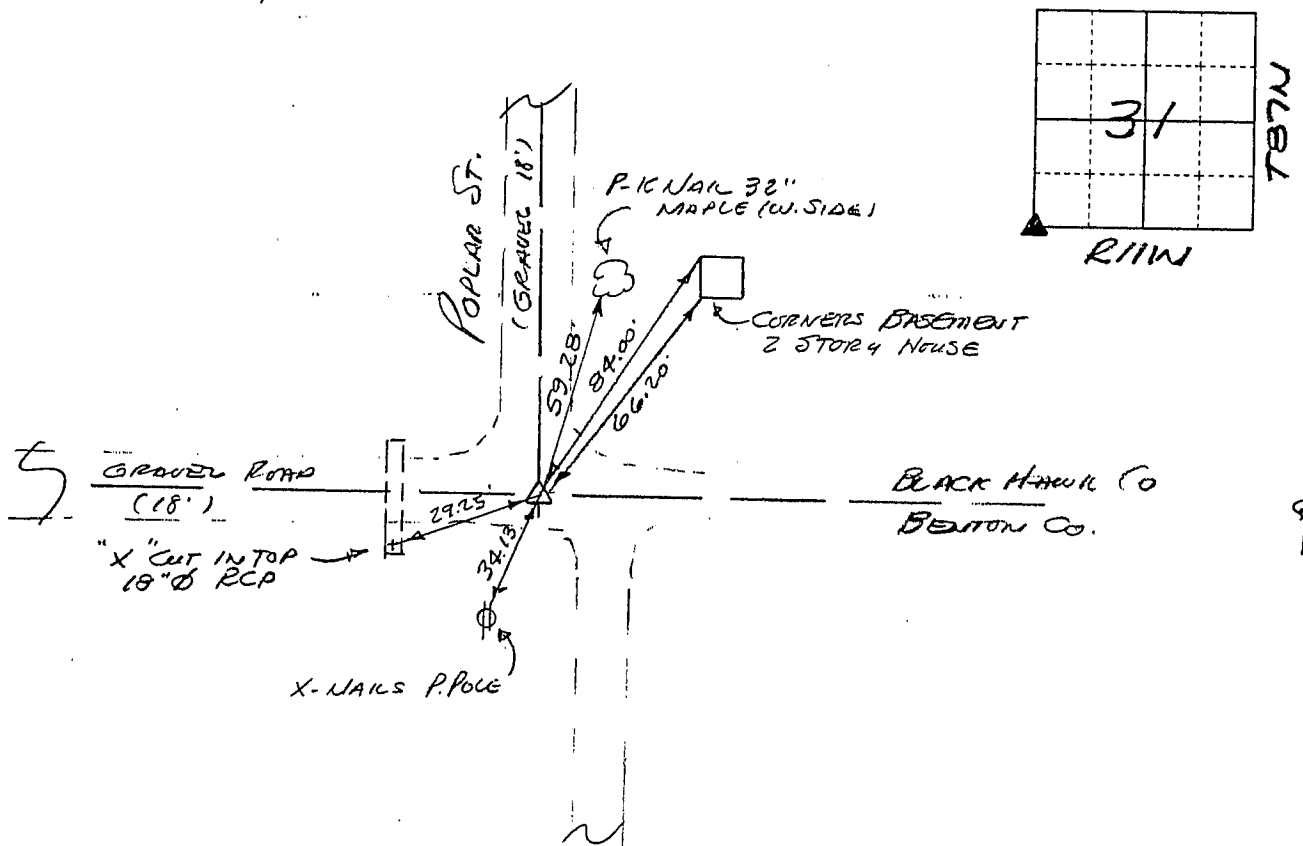


477-12

I hereby certify that the survey work was completed and this certificate was prepared by me or under my direct personal supervision and that I am a duly licensed land surveyor under the laws of the state of Iowa.

Signature: F. William King
(Name typed or printed:) F. WILLIAM KING

Date: JUNE 23, 1997 Lic. No. 8033

SEAL

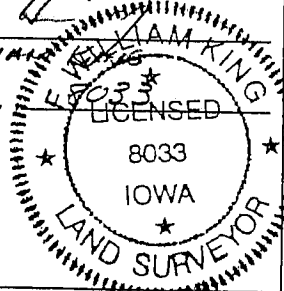

List Corners to be Indexed

Corners	Section	Twp	Range
SW	31	87N	11W

BOOK 326 PAGE 069