

UNITED STATES PUBLIC LAND SURVEY
CORNER CERTIFICATE OF

LAND SURVEY SITUATED IN:	Section 32, Township 87 North, Range 11 West, of the Fifth Principal Meridian, Black Hawk County, Iowa.
PREVIOUSLY RECORDED IN BOOK:	Book __, Page __
INSTRUMENT #:	
FIELD WORK COMPLETED:	9-4-20149
SURVEY PREPARED BY:	CLAPSADDLE-GARBER ASSOCIATES, INC,
RESPOND TO: MARC HOODJER	16 EAST MAIN STREET, P.O. BOX 754, MARSHALLTOWN, IOWA 50158 PHONE 641-752-6701 MHOODJER@CGACONSULTANTS.COM



Doc ID: 009804660001 Type: GEN
Recorded: 04/17/2020 at 02:15:14 PM
Fee Amt: \$0.00 Page 1 of 1
Black Hawk County Iowa
SANDIE L. SMITH RECORDER

File 2020-00017991

THIS CERTIFICATE WAS PREPARED BECAUSE THE LISTED CORNERS WERE REMOVED DURING BLACK HAWK COUNTY PROJECT NUMBER
FM-C007(152)--55-07. CORNERS WERE SET USING METHODS DESCRIBED BELOW.

PLAN-VIEW


NO SCALE

LEGEND:

- ▲ GOVERNMENT CORNER MONUMENT FOUND
- △ GOVERNMENT CORNER MONUMENT SET
- 1/2" x 30" REBAR w/YELLOW PLASTIC ID CAP #22634
- PARCEL OR LOT CORNER MONUMENT FOUND
- EXISTING FENCE
- NAIL w/SM NAIL WITH SURVEY MARKER




- BLACK HAWK COUNTY -

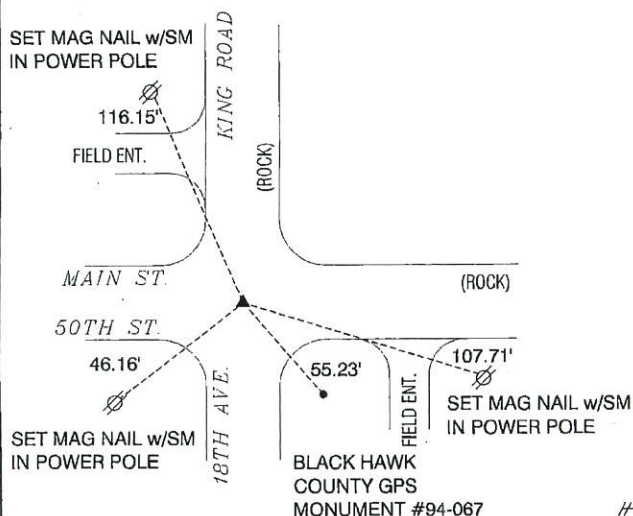

- BENTON COUNTY -

SE CORNER
SECTION 32-87-11

FND 1/2" REBAR
5" DEEP
USING INFORMATION OBTAINED FROM
COUNTY ENGINEER OFFICE

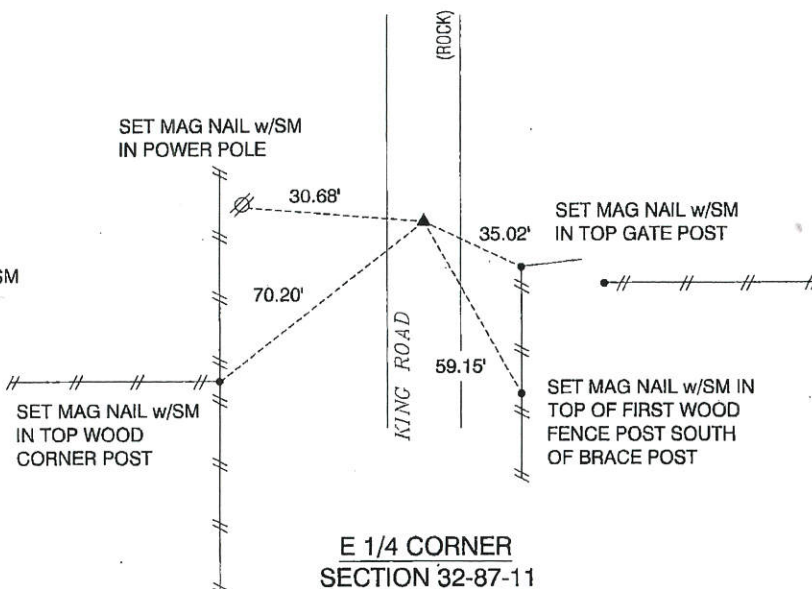

E 1/4 CORNER
SECTION 32-87-11

FND CONCRETE MONUMENT
w/ BRASS DISK
6" DEEP
USING INFORMATION OBTAINED FROM
COUNTY ENGINEER OFFICE

NOTES:

- 1) CORNER ID 8'± NORTH OF FENCE RUNNING EAST
- 2) CORNER IS 56'± NORTH OF FENCE RUNNING WEST
- 3) CORNER IN 183'± NORTH OF NORTH END OF BRIDGE DECK



Clapsaddle-Garber Associates, Inc
5106 Nordic Drive
Cedar Falls, Iowa 50613
Ph 319-266-0258
www.cgaconsultants.com

DRAWN
CAQ

SHEET NO.
1

DATE
9-7-2019

PROJECT NO.
78321.05

List Corners to be Indexed

Corners	Section	Township	Range
SE COR	32	87 78N	11W
E 1/4 COR	32	87 78N	11W



I hereby certify that this land surveying document was prepared and the related survey work was performed by me or under my direct personal supervision and that I am a duly Licensed Professional Land Surveyor under the laws of the State of Iowa.

Marc C. Hoodjer, PLS
Iowa License Number 22634
My License Renewal Date is December 31, 2020
Pages or sheets covered by this seal: THIS SHEET

12/16/19
date