

INDEX *u*  
 MARGIN  
 PROOF  
 COMPARE

BLACK HAWK COUNTY IOWA:SS **028111**  
 Filed for record APR 17, 2002 at  
 4:00 P.M. and recorded in Book \_\_\_\_\_  
 of \_\_\_\_\_ Page \_\_\_\_\_  
*Paul H. Helland* RECORDER  
 FEE 1-5.00X  
 HELLAND ENGINEERING & SURVEYING LTD

Paul H. Helland, 1107 Technology Parkway, Cedar Falls, Iowa 50613-6951, (319)-266-0161

UNITED STATES PUBLIC LAND SURVEY CORNER CERTIFICATE  
 OF

LAND SURVEY MONUMENTS SITUATED IN SECTION NO. 33, TOWNSHIP NO. 87 NORTH, RANGE  
 NO. 11 WEST OF THE FIFTH PRINCIPAL MERIDIAN, BLACK HAWK COUNTY, IOWA.

PREVIOUSLY RECORDED IN BOOK \_\_\_\_\_, PAGE \_\_\_\_\_.


(SHOW REASON FOR PREPARING THIS CERTIFICATE, THE EVIDENCE AND DETAILED PROCEDURES USED IN ESTABLISHING THE  
 CORNER POSITIONS AND MONUMENTATION FOUND OR PLACED.)

MONUMENT DESCRIPTION AND REMARKS:

SURVEY DONE IN N 1/2 OF SEC. 33-T87N-R11W. NO CERTIFICATE ON FILE IN BLACK HAWK COUNTY, IOWA.  
 N 1/4 CORNER: WPA NOTES DATED 9/20/1941 & 9/29/1941 CALL FOR A CONCRETE MONUMENT SET @ N 1/4 CORNER AND A WITNESS  
 CORNER SET 481' WEST OF THE N 1/4 CORNER. C.M. @ N 1/4 CORNER OBLITERATED BY THE CEDAR RIVER. THE N 1/4 CORNER WAS  
 ESTABLISHED USING A LIMESTONE 661.6 FEET EAST OF THE NW CORNER OF SAID SEC. 33 AND PRORATING DISTANCE EAST.  
 LIMESTONE WAS EXCAVATED FOR, BUT NONE WAS FOUND. WITNESS CORNER WAS ALSO OBLITERATED BY THE CEDAR RIVER, CORNER  
 FALLS 6' BELOW & 10'± EAST OF FORMER WEST BANK OF THE CEDAR RIVER IN LOWLAND. FOUND ONE REMAINING BEARING TREE  
 (60" MAPLE) TO SAID WITNESS CORNER 130.25' NW PER WPA NOTES. REESTABLISHED WITNESS CORNER LOCATION BY INTERSECTING  
 BEARING TREE DISTANCE 130.25' AND STATIONING 2165.4' FROM THE NW CORNER. SET A MEANDER POINT ON THE SOUTH LINE OF THE  
 NORTH 20 FEET OF THE NW 1/4 OF SEC. 33.


PLAN VIEW

(SHOW A MINIMUM OF THREE REFERENCE TIES TO DURABLE PHYSICAL OBJECTS, RELEVANT MONUMENTS AND PHYSICAL  
 CONDITIONS THAT WILL ENABLE RECOVERY OF THE CORNER.)

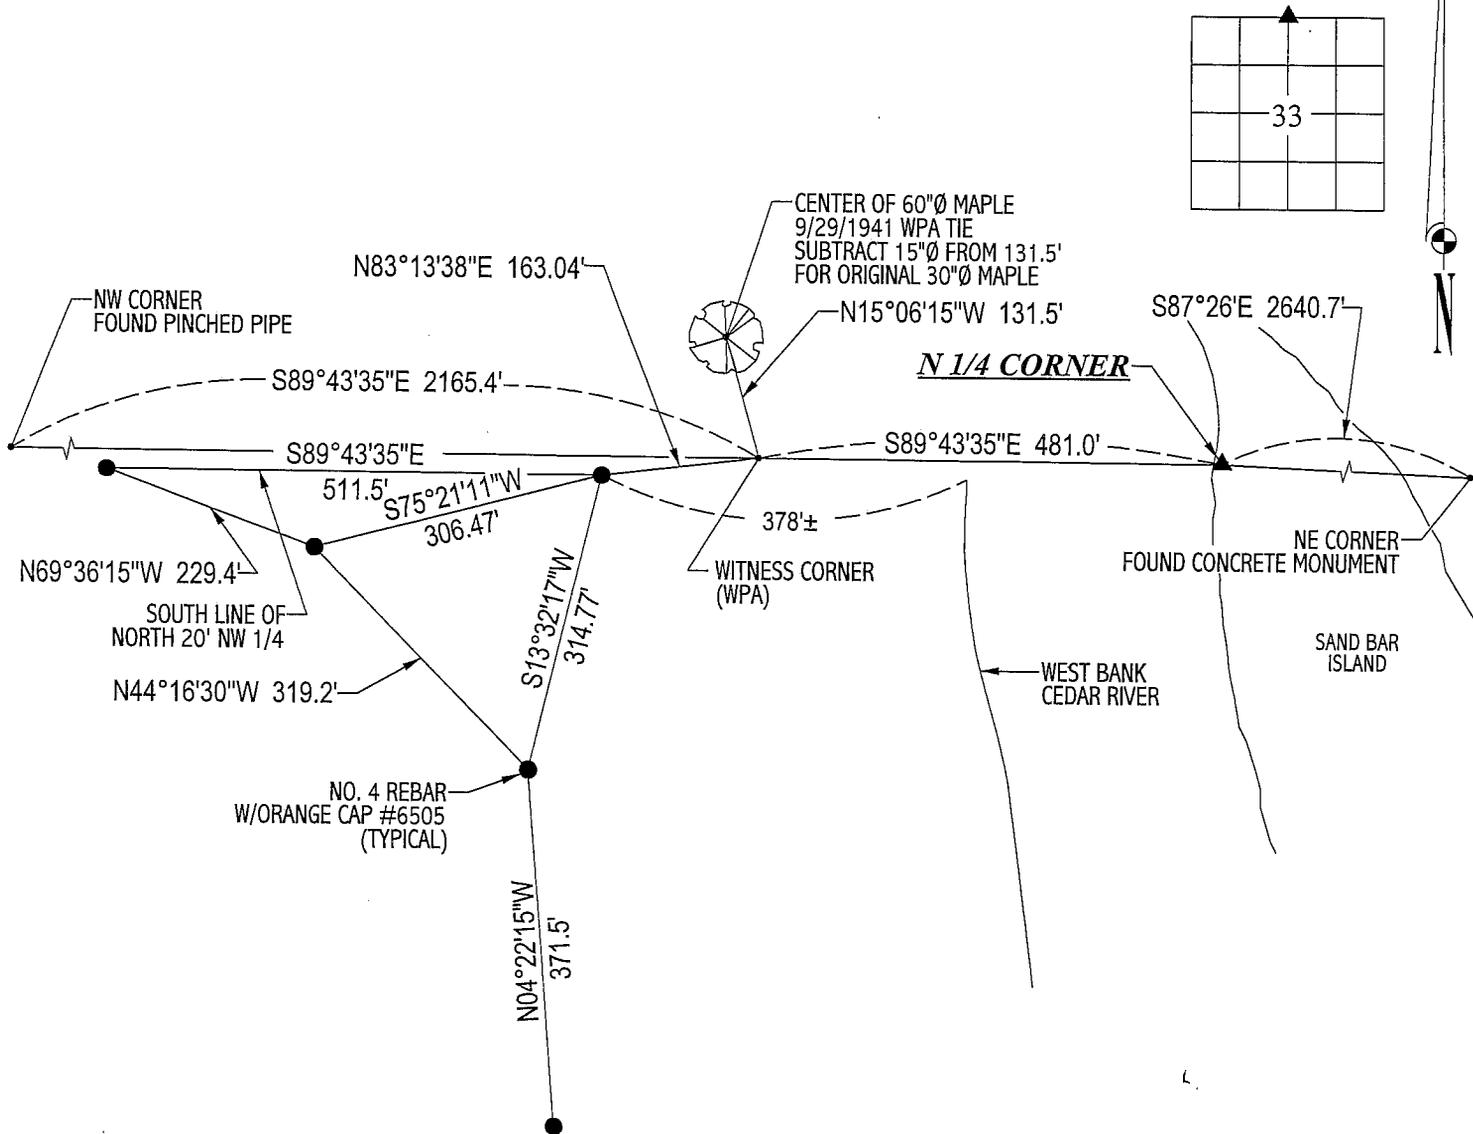

**HES** HELLAND ENGINEERING & SURVEYING, LTD.  
 1107 Technology Parkway  
 Cedar Falls, Iowa 50613-6951  
 (319)-266-0161

FILE NAME: 02-147C2.DRG

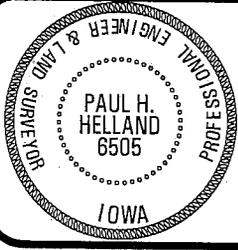

I hereby certify that this land surveying document was prepared  
 and the related survey work was performed by me or under my  
 direct personal supervision and that I am a duly licensed Land  
 Surveyor under the laws of the State of Iowa.  
*Paul H. Helland 4/17/02*  
 Paul H. Helland  
 License Number 6505  
 My license renewal date is December 31, 2003.  
 All pages or sheets are covered by this seal except:

LIST CORNERS TO BE INDEXED

CORNER	SECTION	TOWNSHIP	RANGE
N 1/4 CORNER	33	87N	11W