

INDEX 16  
MARGIN  
PROOF  
COMPARE

BLACK HAWK COUNTY IOWA:SS 028110  
Filed for record APR 17, 2002 at  
4:00 P.M. and recorded in Book \_\_\_\_\_  
of \_\_\_\_\_ Page \_\_\_\_\_  
*Paul H. Helland* RECORDER  
FEE 1-5.00X .  
HELLAND ENGINEERING & SURVEYING LTD

Paul H. Helland, 1107 Technology Parkway, Cedar Falls, Iowa 50613-6951, (319)-266-0161

## UNITED STATES PUBLIC LAND SURVEY CORNER CERTIFICATE OF

LAND SURVEY MONUMENTS SITUATED IN SECTION NO. 33, TOWNSHIP NO. 87 NORTH, RANGE  
NO. 11 WEST OF THE FIFTH PRINCIPAL MERIDIAN, BLACK HAWK COUNTY, IOWA.  
PREVIOUSLY RECORDED IN BOOK \_\_\_\_\_, PAGE \_\_\_\_\_.

(SHOW REASON FOR PREPARING THIS CERTIFICATE, THE EVIDENCE AND DETAILED PROCEDURES USED IN ESTABLISHING THE  
CORNER POSITIONS AND MONUMENTATION FOUND OR PLACED.)

### MONUMENT DESCRIPTION AND REMARKS:


SURVEY DONE IN N 1/2 OF SEC. 33-T87N-R11W. NO CERTIFICATES ON FILE IN BLACK HAWK COUNTY, IOWA.

NW CORNER: FOUND CONCRETE MONUMENT W/BRASS CAP "28, 27" 0.4' DEEP PER WPA NOTES DATED 11/13/1939. SET NO. 4 REBAR ON  
NORTH SIDE OF C.M. FOR MAGNETIC DETECTION. 33+34 C.M. IS 0.9' SOUTH & 0.6' EAST OF CORNER POST.

S 1/4 CORNER: FOUND CONCRETE MONUMENT W/BRASS CAP "33" 1.2' DEEP PER WPA NOTES DATED 10/26/1939. USPLSCC BY  
STEPHEN M. BRUNER ON FILE IN BOOK 11 PG 389 IN THE 4 OFFICE OF THE BENTON COUNTY RECORDER.

### PLAN VIEW

(SHOW A MINIMUM OF THREE REFERENCE TIES TO DURABLE PHYSICAL OBJECTS, RELEVANT MONUMENTS AND PHYSICAL  
CONDITIONS THAT WILL ENABLE RECOVERY OF THE CORNER.)

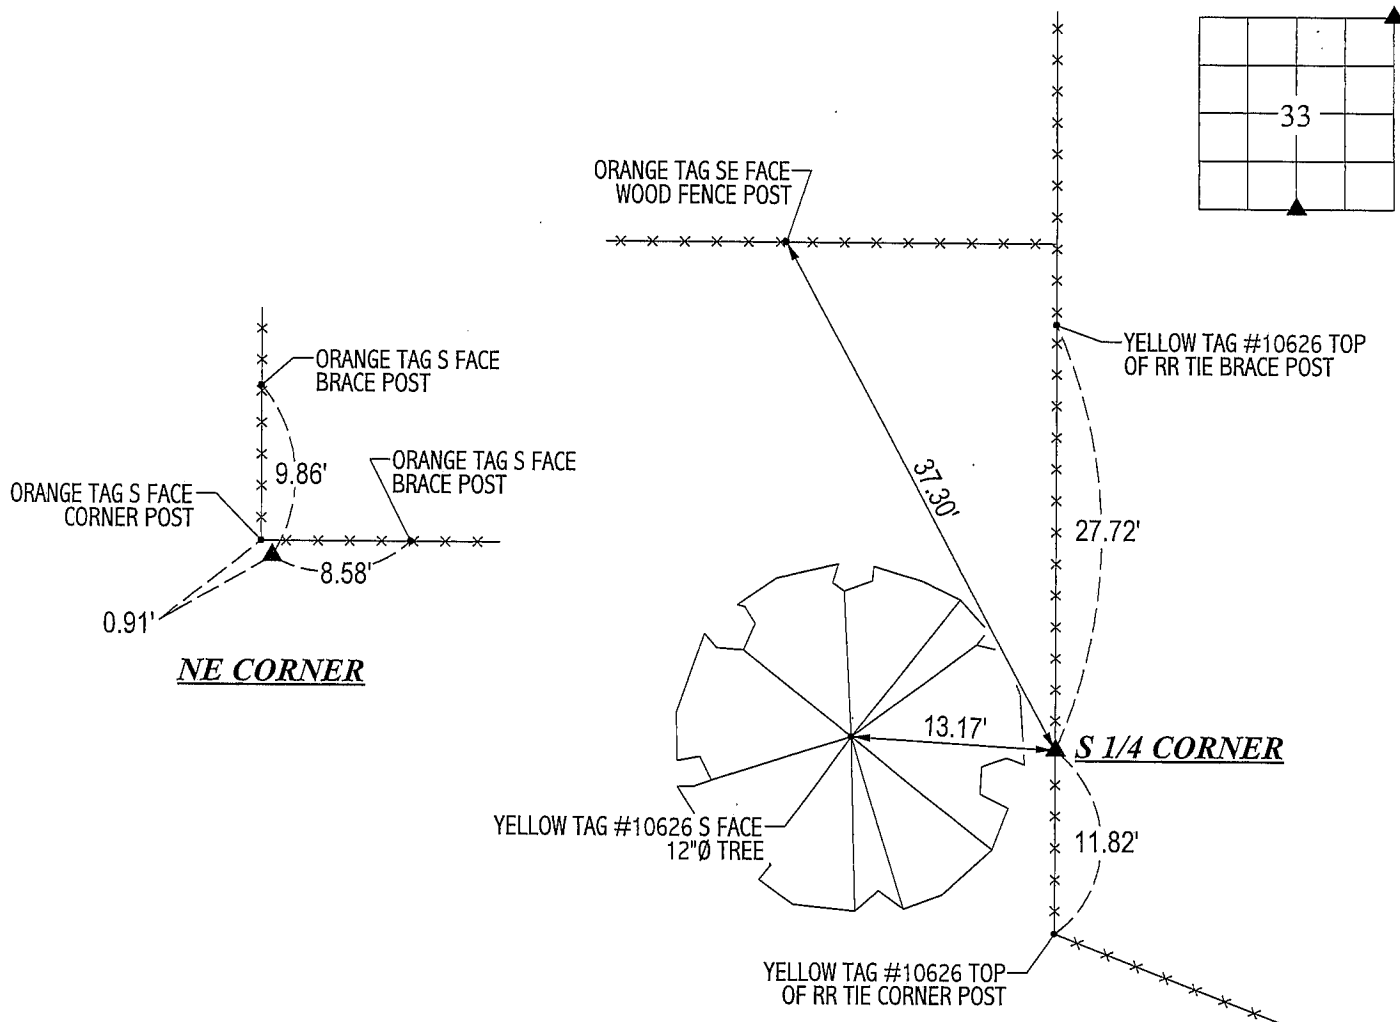

HELLAND ENGINEERING & SURVEYING, LTD.  
1107 Technology Parkway  
Cedar Falls, Iowa 50613-6951  
(319)-266-0161

FILE NAME: 02-147C1.DRG



I hereby certify that this land surveying document was prepared  
and the related survey work was performed by me or under my  
direct personal supervision and that I am a duly licensed Land  
Surveyor under the laws of the State of Iowa.

*Paul H. Helland 4/17/02*

Paul H. Helland  
License Number 6505  
My license renewal date is December 31, 2003.  
All pages or sheets are covered by this seal except:

### LIST CORNERS TO BE INDEXED

CORNER	SECTION	TOWNSHIP	RANGE
NE CORNER	33	87N	11W
S 1/4 CORNER	33	87N	11W