

SC ✓
MISC ✓
INDEX *BN*
MARGIN *BN*
PROOF *gn*
COMPARE

013511
BLACK HAWK COUNTY IOWA:SS
Filed for record MAR 21, 2000 at
4:00 P.M. and recorded in Book 337
of MISC Page 746
Patricia A. Liss RECORDER
FEE 1-5.00/
HELLAND ENGINEERING & SURVEYING, LTD.

Paul H. Helland, 1107 Technology Parkway, Cedar Falls, Iowa 50613-6951, (319)-266-0161

UNITED STATES PUBLIC LAND SURVEY CORNER CERTIFICATE OF

LAND SURVEY MONUMENTS SITUATED IN SECTION NO. 36, TOWNSHIP NO. 87 NORTH, RANGE
NO. 11 WEST OF THE FIFTH PRINCIPAL MERIDIAN, BLACK HAWK COUNTY, IOWA.

PREVIOUSLY RECORDED IN BOOK _____, PAGE _____.

(SHOW REASON FOR PREPARING THIS CERTIFICATE, THE EVIDENCE AND DETAILED PROCEDURES USED IN ESTABLISHING THE
CORNER POSITIONS AND MONUMENTATION FOUND OR PLACED.)


MONUMENT DESCRIPTION AND REMARKS:

SURVEY DONE IN SEC.S 25, 26, 35 & 36.

NE CORNER: All county reference ties are lost. Corner in cultivated field. With help of Black Hawk County Engineer's Office
started digging from chaining notes. Found broken off top of concrete monument w/brass cap (1' of top) approximately 1' North
of base. Base of concrete monument leaning SEly, found original government wood post 4.5' deep below concrete monument.
Lowered base of concrete monument & placed top with four No. 4 rebars on @ side for support. Found 18" granite stone
w/chisled "X" South of monument, "X" on stone was facing down as if stone was replaced by concrete monument.

PLAN VIEW

(SHOW A MINIMUM OF THREE REFERENCE TIES TO DURABLE PHYSICAL OBJECTS, RELEVANT MONUMENTS AND PHYSICAL
CONDITIONS THAT WILL ENABLE RECOVERY OF THE CORNER.)

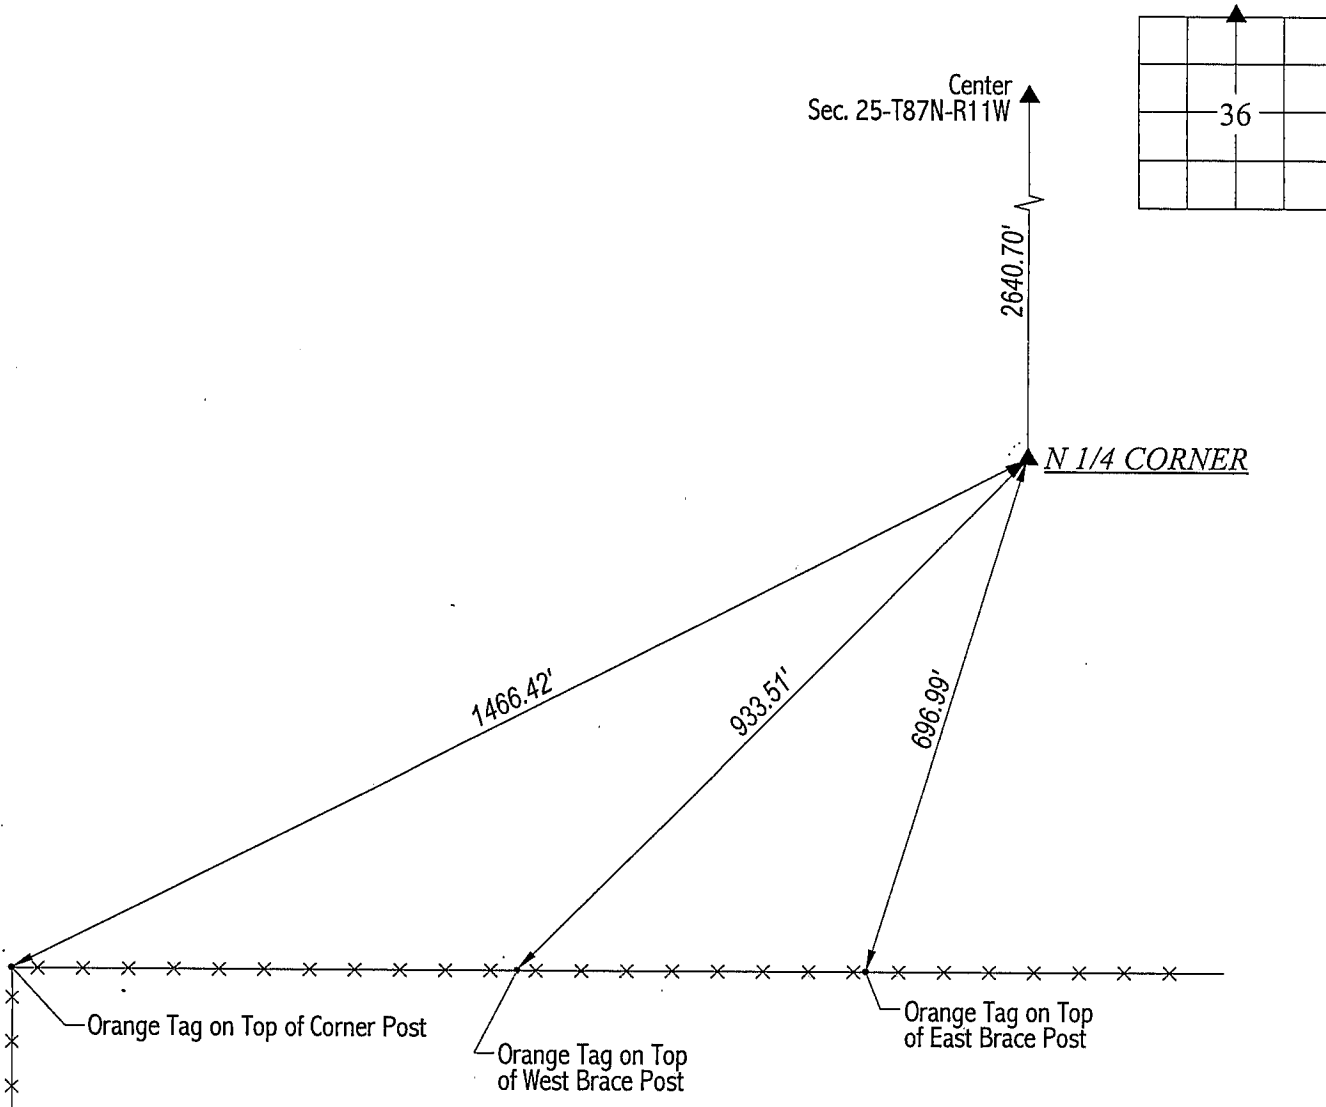

HELLAND ENGINEERING & SURVEYING, LTD.
1107 Technology Parkway
Cedar Falls, Iowa 50613-6951
(319)-266-0161

FILE NAME: 00-116CC.DRG



I hereby certify that this land surveying document was prepared
and the related survey work was performed by me or under my
direct personal supervision and that I am a duly licensed Land
Surveyor under the laws of the State of Iowa.

Paul H. Helland 3/20/00
Paul H. Helland
License Number 6505
My license renewal date is December 31, 2001.
All pages or sheets are covered by this seal except:

LIST CORNERS TO BE INDEXED			
CORNER	SECTION	TOWNSHIP	RANGE
N 1/4 CORNER	36	87N	11W